
DX 78-1

Grant KANSAS

Section 31 Township 28 Range 36 W

Well No. # 1 D. Hinshaw

Company Columbian Fuel

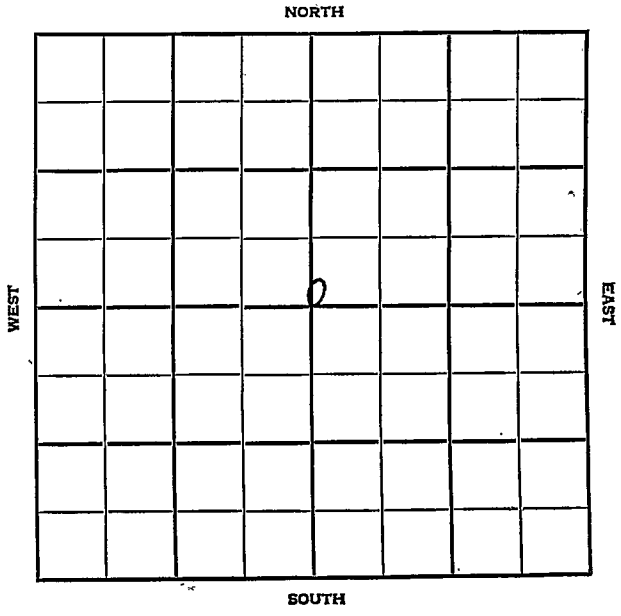

Grant KANSAS

SEC.	TWP.	R.
31	28	36W

WELL NO.

L. D. Hinshaw FARM

COMPANY

Columbian Fuel

CONTRACTOR

Midwestern Drlg.


oronto Test

_____ Ft. from N. Line

100 Ft. from S. Line

_____ Ft. from E. Line

100 Ft. from W. Line

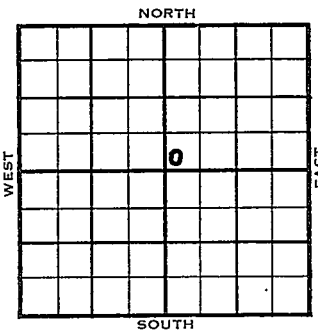

SW SW NE

	ELEVATION	REPORT
1955	3094'	

Toronto Test

2/23 Spud 2-16-55
Anhy 1769'
9" @ 1850'
Drlg.2577'

~~$XXX~~

4/27 Spud 2-16-55 - Gas Well
TD
Anhy 1769'
9" @ 1850'
Hol. 2450', Her. 2495', Kri 2520',
Win. 2570', Ft. Riley 2645'
DST 4037-75', opn 1 hr., rec. 150'
mud, 1500#
DST 4130-42', opn 1 hr., rec. 135'
salty mud, 30' sw, 1050#
5" @ 2810'
CO to 2743'
TD 4175'
CO to 2772', 56/2532-46, 72/2556-74,
84/2599-2620, 116/2670-99, 120/2715-45
1500A, perf 2715-45, 3500A
823,000 cfg, 30 gwph, 4000A
1,275,000 cfg, SI 2 hrs.
1,562,000 cfg, SI 3 hrs.
Comp. SI Gas Well 4,094,000 cfg,
364#

OVER

DX-78

(Information Brought Forward)

1955
4/27 Schl Tops: Her. 2500', Kri. 2552', Win. 2598', Ft. Riley 2653', F. Flint 2984', Tor. 3984', Lans. 4069'

COMPLETED

FORM 275 FOR SALE BY KANSAS BLUE PRINT CO.


County Grant State Kansas

Sec. 31 (Blk. Twp.) 28 (Sur. Rge.) 36W Map No.

Operator Columbian Fuel

Well No. 1 Farm D. Hinshaw

Elev. 3094 Location SW SW NE

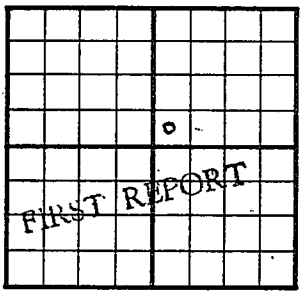

100 Ft. From S Line NE

100 Ft. From W Line Quarter

1st. Report FEB 23 1955

Completion

Remarks Toronto test

Midwestern Drlg. - Contr.

Spudding Date 2-16-55

Drlg. Data Hugoton Pool

Anhy 1769 9" @ 1850 drlg. 2577

FABEN GILSTRAP

FORM 275 FOR SALE BY KANSAS BLUE PRINT CO.


County Grant State Kansas

Sec. 31 (Blk. Twp.) 28 (Sur. Rge.) 36W Map No.

Operator Columbian Fuel

Well No. 1 Farm D. Hinshaw

Elev. 3098 Location SW SW NE

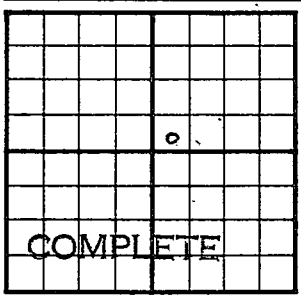

100 Ft. From S Line NE

100 Ft. From W Line Quarter

1st. Report

Completion APR 2 7 1955

Remarks Hugoton Pool

Midwestern Drlg. - Contr

Spudding Date 2-16-55

Drlg. Data Gas well TD

Anhy 1769 9" @ 1850 Hol. 2450

Her. 2495 Kri. 2520 Win. 2570

Ft. Riley 2645 DST 4037-75 open 1 hr.

Rec. 150' mud 1500# DST 4130-42

open 1 hr. Rec. 135' salty mud 30' sw

1050# 5" @ 2810 CO to 2743 TD 4175

CO to 2772 56/ 2532-46 72/ 2556-74

84/ 2599-2620 116/ 2670-99

120/ 2715-45 1500 A perf/ 2715-45

3500 A 823,000 cfg 30 gwph 4000 A

1,275,000 cfg SI 2 hr. 1,562,000 cfg

SI 3 hr. Comp. SI gas well 4,094,000 cfg

364#

(over)


FABEN GILSTRAP

Drlg. Data SCHLUMBERGER TOPS:

Her. 2500 Kri. 2552 Win. 2598

Ft. Riley 2653 E. flint 2984

Tor. 3984 Lans. 4069

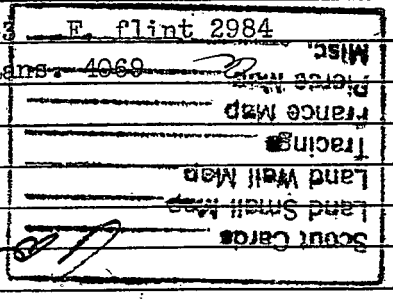

May 4 1955