Pratt


FORM 51

KANSAS

Section 28 Township 28 Range 12W

Well No. #1 Petrie

Company B & R Drlg.

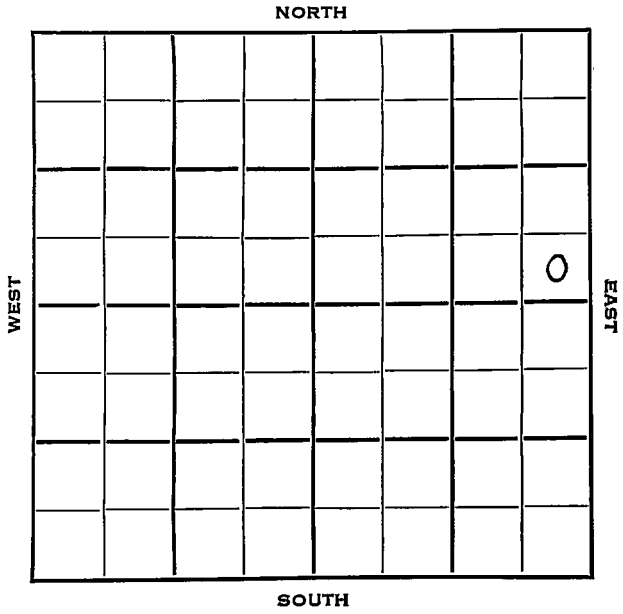

Pratt. KANSAS

SEC.	TWP.	R.
28	28	12 W

WELL NO.

1 Petrie FARM

COMPANY

B & R Drlg.

CONTRACTOR

Semi Wildcat


_____ Ft. from N. Line

330 Ft. from S. Line

330 Ft. from E. Line

_____ Ft. from W. Line

SE SE NE

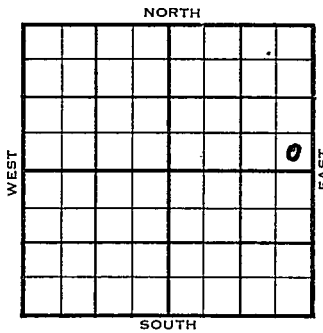

1953	ELEVATION 1885'	REPORT
12/9		Location
12/16		8" @ 392' Heeb 3547', Doug 3613', Br. L. 3766' Lans 3776' DST 3887'-3903'
1954 5/5		Spud 12-3-53 D & A TD 4602' 8" @ 392 Heeb 3547 Doug 3613 Br. lime 3766 Lans 3776 DST 3887-3903 open 1 hr rec 110' wtr. 60' gas. 1200# Miss 4192 Viola 4348 DST 4349-97 open 1½ hr rec 50' mud 350# Simp. 4452 DST 4450-90 open 1 hr rec 60' OCM 120' muddy GCO, 120' GCO, 600' O & GCW 877# Arb. 4561 TD 4602 5" @ 4583 CO to 4602 12/4458-60 S/30 BO 150 BW 500 A P/10 BO 24 hr. 87% wtr. CO to 4536 12/4458-60 S/5 BFPH 250 A S/wtr. CO to 4535 16/4475-79 500 A S/6 BWPH PB 4470 12/4465-69 S/wtr. PB 4461' 6/4456-58 8/4456-58 HFW & SSO D & A

DX-78

ABANDONED

FORM 275 FOR SALE BY KANSAS BLUE PRINT CO.


County Pratt State Kansas

Sec. 28 (Blk. Twp.) 28 (Sur. Rge.) 12W Map No.

Operator B & R Drlg.

Well No. 1 Farm Petrie

Elev. Location SE SE NE

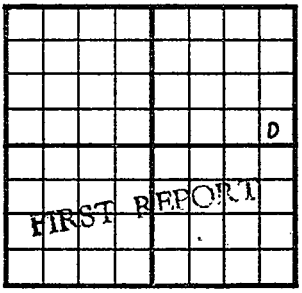

330 Ft. From S Line NE

330 Ft. From E Line Quarter

1st. Report DEC 9 1953

Completion

Remarks

Spudding Date

Drlg. Data Semi Wildcat

Location

J. G. McGEHEE

FORM 275 FOR SALE BY KANSAS BLUE PRINT CO.


County Pratt State Kansas

Sec. 28 (Blk. Twp.) 28 (Sur. Rge.) 12W Map No.

Operator B & R Drlg.

Well No. 1 Farm Petrie

Elev. 1885 Location SE SE NE

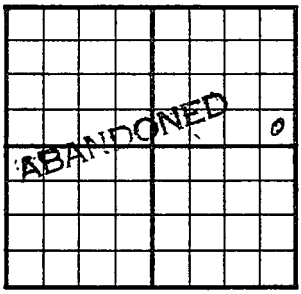

330 Ft. From S Line NE

330 Ft. From E Line Quarter

1st. Report

Completion MAY 5 1954

Remarks Semi Wildcat

Spudding Date 12-3-53

Drlg. Data D & A TD 4602

8" @ 392 Heeb. 3547 Doug. 3613

Br. lime 3766 Lans. 3776 DST 3887-3903

open 1 hr. Rec. 110' wtr. 60' gas

1200# Miss. 4192 Viola 4348 DST 4349-

97 open 1½ hr. Rec. 50' mud 350#

Simp. 4452 DST 4450-90 open 1 hr.

Rec. 60' ocm 120' muddy gco 120' gco

600' o & gcw 877# Arb. 4561 TD 4602

5" @ 4583 CO to 4602 12/ 4458-60

S/ 30 bo 150 bw 500 A P/ 10 bo

24 hr. 87% wtr. CO to 4536 12/ 4458-

60 S/ 5 bfph 250 A S/ wtr. CO to 453


4535 16/ 4475-79 500 A S/ 6 bwph

PB 4470 12/ 4465-69 S/ wtr. PB 4461

J. G. McGEHEE

Drlg. Data

6/ 4456-58 8/ 4456-58

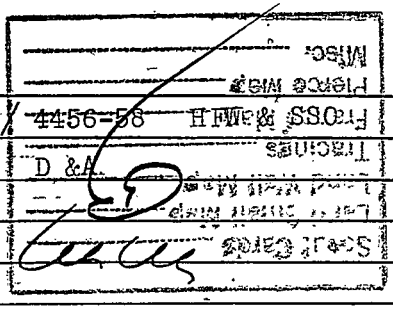

May 10 1958