


Map No. Kansas Sec. 14 Twp. 31 R. 10

Well No. 2 Chaffin Farm
Pure Oil Company

200 Ft. from N. Line
_____ Ft. from S. Line
1320 Ft. from E. Line
_____ Ft. from W. Line

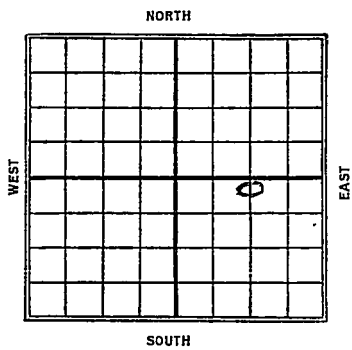

Date 1927

REPORT

1/8 Land 1335-51 75 bbls

Map No. **4** KANSAS Sec. **14** Twp. **31** R. **10^E**

Well No. **2 Chadden**

Pule Oil Co Company

Contractor

FIRST REPORTS

SECTION PLAT

200 Ft. from N. Line

Ft. from S. Line

1320 Ft. from E. Line

Ft. from W. Line

COMPLETED

		o	

Location -----

Rig up -----

Drilling and Remarks:

75 lbs.

RECORD

Cased _____ in., _____ ft.

Sand **1335-1351**

Gas -----

Oil -----

Total Depth **1351**

PRODUCTION

1st 24 hrs. Nat. -----

1st 24 hrs. after shot. -----

Gas ----- Cu. Ft.

Dry Hole -----

Abandoned -----

Date

JAN 8 1927

CHAS. L. SHERWOOD

-----192----- Scout