


Map No. 15 Sec. 14 Twp. 3 R. 10 E

Well No. 10 - Chappin Farm
Pure Oil Company

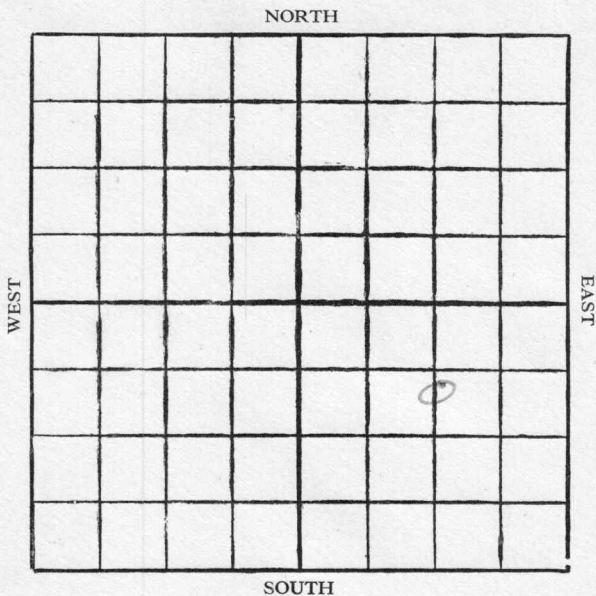

Location

Drilling Remarks

.....

.....

RECORD

Cased..... in. ft.

Sand

Gas

Oil

Total Depth.....

Rig Up.....

Drilling Remarks

.....

.....

PRODUCTION

1st 24 hrs. Nat.....

1st 24 hrs. after shot.....

Gas..... cu. ft.


Dry Hole.....

Abandoned.....

Map No. Kansas Sec. 14 Twp. 31 R. 10

Well No. 10 Chaffin Farm
Pure Oil Company

785 Ft. from N. Line
..... Ft. from S. Line
1320 Ft. from E. Line
..... Ft. from W. Line

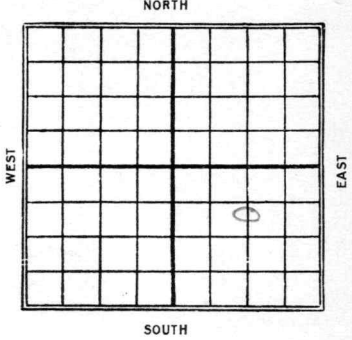

Date

REPORT

1927

1/8 Sand 1320-1356
1st Oil 1343
10 bbls 37 Gravity

4 KANSAS *Edin*
 Map No. _____ Sec. *14* Twp. *31* R. *10^w*

Well No. *10 Chappin*
Pure Oil Co _____ Company

_____ Contractor

FIRST REPORTS

SECTION PLAT

785 Ft. from N. Line

_____ Ft. from S. Line

1320 Ft. from E. Line

_____ Ft. from W. Line

COMPLETED

		o	

Location _____

Rig up _____

Drilling and Remarks:

1st out 1343'

10 lbs.

37 gravity

RECORD

Cased _____ in., _____ ft.

Sand *1320-1356*

Gas _____

Oil _____

Total Depth *1356*

PRODUCTION

1st 24 hrs. Nat. _____

1st 24 hrs. after shot. _____

Gas _____ Cu. Ft.

Dry Hole _____

Abandoned _____

Date

JAN 8 1927

CHAS. L. SHERWOOD

_____ 192 _____ Scout