


Map No. 55 Sec. 14 Twp. 31 R. 10 E  
 Well No. 3-Leffingwell Farm  
Union Gas Corp Company

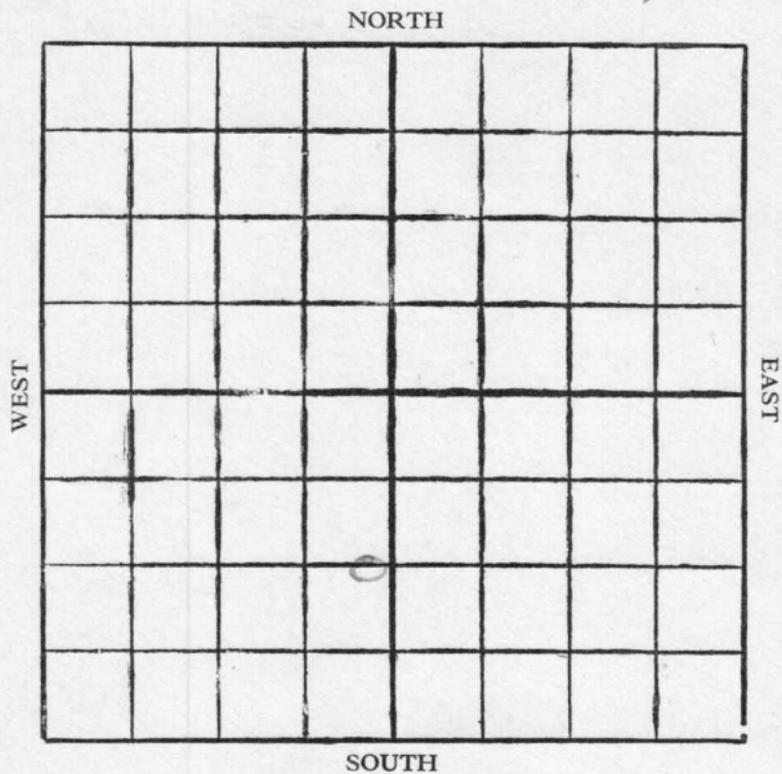

Location .....

Drilling Remarks

Rig Up.....

Drilling Remarks

.....

.....

**RECORD**

**PRODUCTION**

Cased..... in. .... ft.

Sand .....

Gas .....

Oil .....

Total Depth.....

1st 24 hrs. Nat.....

1st 24 hrs. after shot.....

Gas..... cu. ft.

Dry Hole.....

Abandoned.....



4 KANSAS 14 Twp. 31 R. 10<sup>E</sup>  
Map No. Sec. Twp. R.

Well No. 3 Leffingwell

Union Gas Corp Company

Contractor

FIRST REPORTS

SECTION PLAT

1320 Ft. from N. Line

Ft. from S. Line

200 Ft. from E. Line

Ft. from W. Line

COMPLETED


Location

Rig up

Drilling and Remarks:

75 lbs

RECORD

Cased in., ft.

Sand 1348-1363

Gas

Oil

Total Depth 1363

PRODUCTION

1st 24 hrs. Nat.

1st 24 hrs. after shot.

Gas Cu. Ft.

Dry Hole

Abandoned

Date

JAN 8 1927

CHAS. L. SHERWOOD

192

Scout