Form 51-10M-7-20-CroMac

Map No. 5 Sec. 26 Twp. 28 R. 5

Well No. 3 Moulton Farm

Johnson & Calvert Company

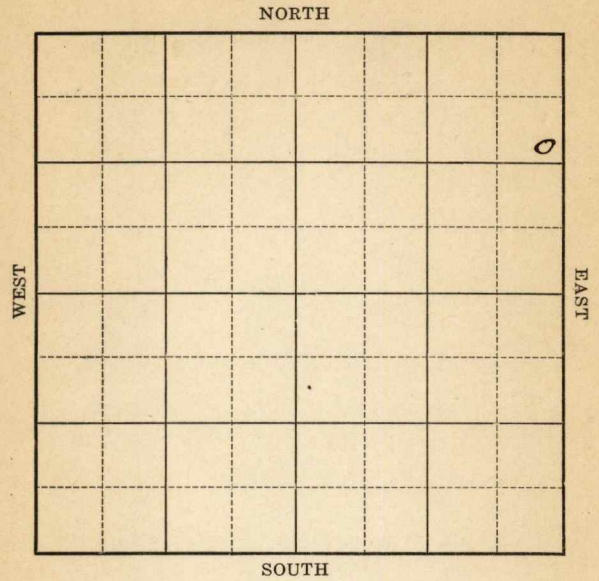

Location _____

Drilling Remarks:

RECORD

Cased _____ in. _____ ft.

Sand _____

Gas _____

Oil _____

Total Depth _____

COMPLETED

Rig Up _____

Drilling Remarks:

PRODUCTION

1st 24 hrs. Nat. _____

1st 24 hrs. after shot _____

Gas _____ cu. ft.

Dry Hole _____

Abandoned _____

Form 252A 8M-11-20 PALACE-TULSA 4617

Map No. K Sec. 26 Twp. 15 R. 5

Well No. 3 Moulter Farm

Johnson Calaha Company

1120 Ft. from N. Line

Ft. from S. Line

200 Ft. from E. Line

Ft. from W. Line

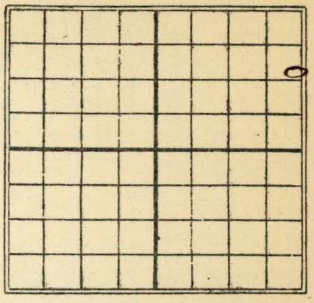

Date	REPORT COMPLETED
1/3	dly 2750'
1/27	Okla A. 2902-
	Sand 2805-20-
	Shot 225 qts -

Form 143—7-20—500 Bks—CroMac

Map No. 11 Sec. 26 Twp. 28 R. 5

Well No. 3 Moulter Farm

Johnson & Callahan Company

Date Started _____ Ft. from N 1120 S ____ E 202 W ____ line

NORTH Kansas

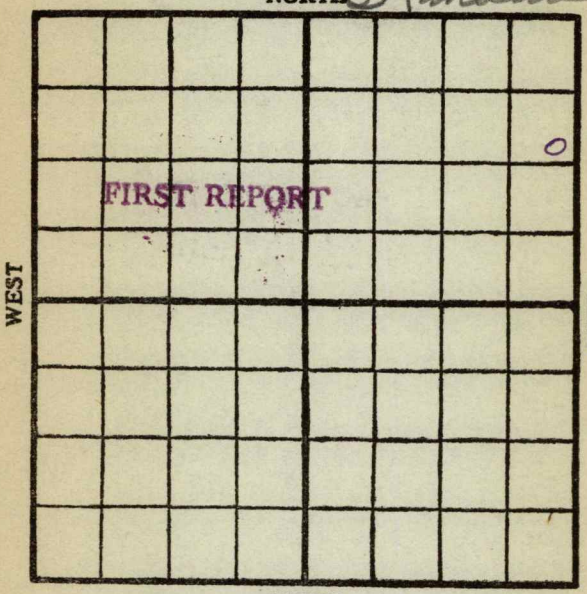

Cased ____ In. ____ Ft.	Production Remarks
Sand ____	
Pay { Gas ____	
Pay { Oil ____	
Total Depth ____	

Condition of Well on this date _____

Dolly at 2756'

M. A. BENEAR

_____ Scout

Form 26—1M—4-19—Mid-West

Map No. K11 Sec. 26 Twp. 28 R. 5

Well No. 3 Matter

Johnson & Calahan Company

Contractor

ABANDONED

SECTION PLAT

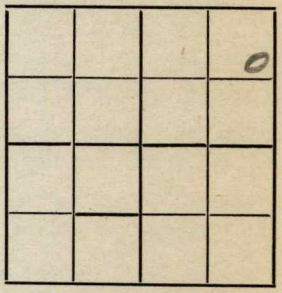

1120' Ft. from N. Line

Ft. from S. Line

200' Ft. from E. Line

Ft. from W. Line

Location

Rig up

Drilling and Remarks:

L & G 2902'
sand 2805-29
shot 225
qts.

RECORD

Cased in., ft.

Sand

Gas

Oil

Total Depth

PRODUCTION

1st 24 hrs. Nat.

1st 24 hrs. after shot

Gas Cu. Ft.

Dry Hole

Abandoned

Date

JAN 27 1922 191

M. A. BENEAR Scout