



Map No. Kansas Sec. 14 Twp. 31 R. 10


Well No. 4 Leffingwell Farm  
Union Gas Company

..... Ft. from N. Line

760 Ft. from S. Line

220 Ft. from E. Line

..... Ft. from W. Line

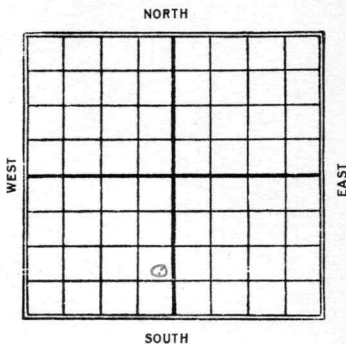

Date 1927 REPORT

1/8 Sand 1352-1368 T.D. 1370  
50 bbls

Map No. 4 KANSAS Sec. 14 Twp. 31 R. 10

Well No. 4 Leppingwell

Union Gas Corp Company

Contractor

FIRST REPORTS

SECTION PLAT

Ft. from N. Line

760 Ft. from S. Line

220 Ft. from E. Line

Ft. from W. Line


COMPLETED

Location

Rig up

Drilling and Remarks:

50 lbs.

RECORD

Cased in. ft.

Sand 1352-1368

Gas

Oil

Total Depth 1370

PRODUCTION

1st 24 hrs. Nat.

1st 24 hrs. after shot

Gas Cu. Ft.

Dry Hole

Abandoned

Date

JAN 8 1927

CHAS. L. SHERWOOD

192

Scout