


ELK

Map No. *Kansas* Sec. *14* Twp. *31* R. *10^E*

Well No. *3 Webb* Farm
Union Gas Company

NORTH

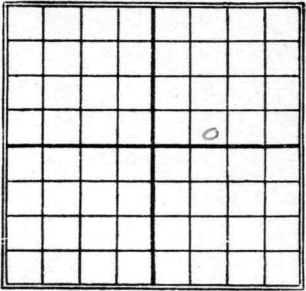

..... Ft. from N. Line

200 Ft. from S. Line

..... Ft. from E. Line

1120 Ft. from W. Line

SOUTH

Date

1927

REPORT

1/8 Sand 1335-1346
60 bbls

4 KANSAS Map No. Sec. 14 Twp. 31 R. 10^W

Well No. 3 Webb

Union Gas Corp Company

Contractor

FIRST REPORTS

SECTION PLAT

----- Ft. from N. Line

200 ----- Ft. from S. Line

----- Ft. from E. Line

1120 ----- Ft. from W. Line

COMPLETED

		o	

Location -----

Rig up -----

Drilling and Remarks:

60 lbs.

RECORD

Cased _____ in. _____ ft.

Sand 1335-1346

Gas -----

Oil -----

Total Depth 1346

PRODUCTION

1st 24 hrs. Nat. -----

1st 24 hrs. after shot. -----

Gas ----- Cu. Ft.

Dry Hole -----

Abandoned -----

Date

JAN 8 1927

CHAS. L. SHERWOOD

192

Scout