


Map No. 15 Sec. 14 Twp. 31 R. 10

Well No. 15 - Chappin Farm
Pure oil Company

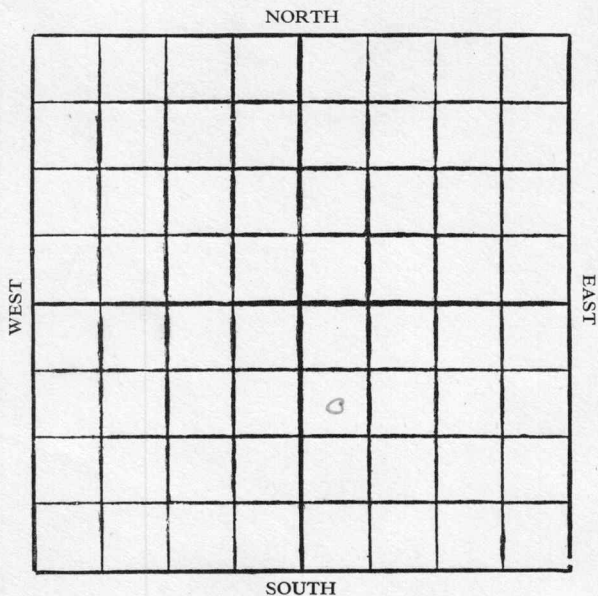

Location

Drilling Remarks

Rig Up

Drilling Remarks

.....

.....

RECORD

PRODUCTION

Cased in. ft.

Sand

Gas

Oil

Total Depth

1st 24 hrs. Nat.

1st 24 hrs. after shot

Gas cu. ft.

Dry Hole

Abandoned

Map No. 4 **KANSAS** Sec. 14 Twp. 31 R. 10

Well No. 15 *Chapman*
Pure Oil Co Company

Contractor

FIRST REPORTS

SECTION PLAT

990 Ft. from N. Line
_____ Ft. from S. Line
_____ Ft. from E. Line
330 Ft. from W. Line

		o	

Location _____
Rig up _____
Drilling and Remarks:

RECORD

Cased _____ in., _____ ft.
Sand _____
Gas _____
Oil _____
Total Depth _____

PRODUCTION

1st 24 hrs. Nat. _____
1st 24 hrs. after shot _____
Gas _____ Cu. Ft.
Dry Hole _____
Abandoned _____

Spudg

Date
JAN 8 1927

CHAS. L. SHERWOOD

192 Scout

blk

4 KANSAS
Map No. _____ Sec. *14* Twp. *31* R. *10*

Well No. *15*
Chas L Sherwood
Inc Company

Contractor

COMPLETED

SECTION PLAT

990 Ft. from N. Line
____ Ft. from S. Line
____ Ft. from E. Line
330 Ft. from W. Line

Location _____
Rig up _____
Drilling and Remarks:

250 lbs.

RECORD

Cased _____ in., _____ ft.
Sand *1628-1644*
Gas _____
Oil _____
Total Depth *1644*

PRODUCTION

1st 24 hrs. Nat. _____
1st 24 hrs. after shot _____
Gas _____ Cu. Ft.
Dry Hole _____
Abandoned _____

Date
FEB 25 1927 **CHAS. L. SHERWOOD**
_____ 192 _____ Scout