


Map No. KANSAS Sec. 14 Twp. 31 R. 10 E

Well No. 16 - Chaffin Farm
Pure Oil Company

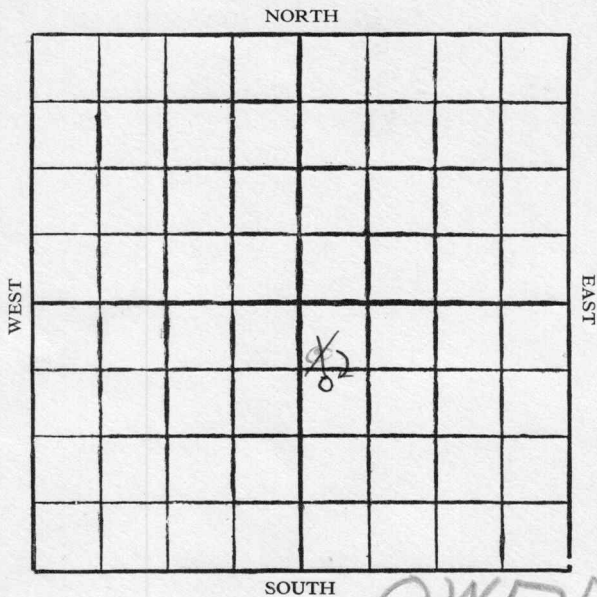

OWDD

Location

Rig Up

Drilling Remarks

Drilling Remarks

.....

.....

RECORD

PRODUCTION

Cased..... in. ft.

Sand

Gas

Oil

Total Depth.....

1st 24 hrs. Nat.....

1st 24 hrs. after shot.....

Gas..... cu. ft.

Dry Hole.....


Abandoned

ELK

Map No. Kansas Sec. 14 Twp. 31 R. 10

Well No. 16 Chaffin Farm
Pure oil Company

750
~~530~~ Ft. from N. Line
Ft. from S. Line
Ft. from E. Line
250
~~200~~ Ft. from W. Line

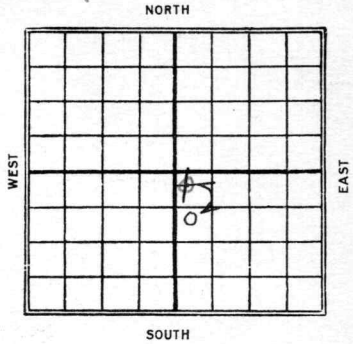

Date	REPORT
1927	
1/8	Drilling 350
2/29	sand 1622-1642
	300 bbls
	38 gravity
1929	OYDID
8/7	Old T.D. 1642'
	Rigs up.
8/14	Base Oswego 1644
	dry 1700'
8/21	top line 1956
	wells 1986
8/28	5"-2265'
9/4	sand 2285-96'
	T.D. 2296'
	52 bbl oil
	25 grav.
	Pump.

Map No. 4 **KANSAS** Sec. 14 Twp. 31 R. 10^E

Well No. 16 *Chapman*
Pure Oil Co Company

Contractor

FIRST REPORTS

SECTION PLAT

530 Ft. from N. Line

_____ Ft. from S. Line

_____ Ft. from E. Line

200 Ft. from W. Line

		o	

Location _____

Rig up _____

Drilling and Remarks:

Only 350

RECORD

Cased _____ in., _____ ft.

Sand _____

Gas _____

Oil _____

Total Depth _____

PRODUCTION

1st 24 hrs. Nat. _____

1st 24 hrs. after shot _____

Gas _____ Cu. Ft.

Dry Hole _____

Abandoned _____

Date
JAN 8 1927

CHAS. L. SHERWOOD

_____ 192 _____ Scout

Elk

Map No. 4 KANSAS Sec. 14 Twp. 31 R. 10

Well No. 16 *Chappin*
Pure oil Co Company

Contractor

COMPLETED

SECTION PLAT

530 Ft. from N. Line
 _____ Ft. from S. Line
 _____ Ft. from E. Line
200 Ft. from W. Line

		o	

Location _____
 Rig up _____
 Drilling and Remarks:

300 Bls.

38°

RECORD

Cased _____ in., _____ ft.
 Sand 1622-1642
 Gas _____
 Oil _____
 Total Depth 1642'

PRODUCTION

1st 24 hrs. Nat. _____
 1st 24 hrs. after shot _____
 Gas _____ Cu. Ft.
 Dry Hole _____
 Abandoned _____

Date

FEB 25 1907

192

CHAS. L. SHERWOOD

Scout

Map No. **KANSAS** Sec. **14** Twp. **31** R. **10^E**

Well No. **16 Chaffin**

Pure Oil Co Company

Contractor

FIRST REPORTS SECTION PLAT

750 Ft. from N. Line

Ft. from S. Line

Ft. from E. Line

750 Ft. from W. Line

Correction
"old well deeper"

Location

Rig up **J. D. 1642'**

Drilling and Remarks:

Rigging up

RECORD

Cased.....in.,ft.

Sand.....

Gas.....

Oil.....

Total Depth.....

PRODUCTION

1st 24 hrs. Nat.....

1st 24 hrs. after shot.....

Gas.....Cu. Ft.

Dry Hole.....

Abandoned.....

Date

AUG 7 1929

CHAS. L. SHERWOOD

Scout

ELK

Map No. KANSAS Sec. 14 Twp. 31 R. 10

Well No. 16 *Chassin*

pure oil Co Company

Contractor

COMPLETE

750 Ft. from N. Line

_____ Ft. from S. Line

_____ Ft. from E. Line

750 Ft. from W. Line

SECTION PLAT

Location _____

Rig up _____

Drilling and Remarks:

*52 Bls,
75 gravity*

RECORD

Cased _____ in., _____ ft.

Sand 2285-2296

Gas _____

Oil _____

Total Depth 2296

PRODUCTION

1st 24 hrs. Nat. _____

1st 24 hrs. after shot _____

Gas _____ Cu. Ft.

Dry Hole _____

Abandoned _____

Date SEP 4 1929

CHAS. L. SHERWOOD