


Map No. 55 Sec. 14 Twp. 31 R. 10E

Well No. 6-Webb Farm
Union Gas Corp. Company

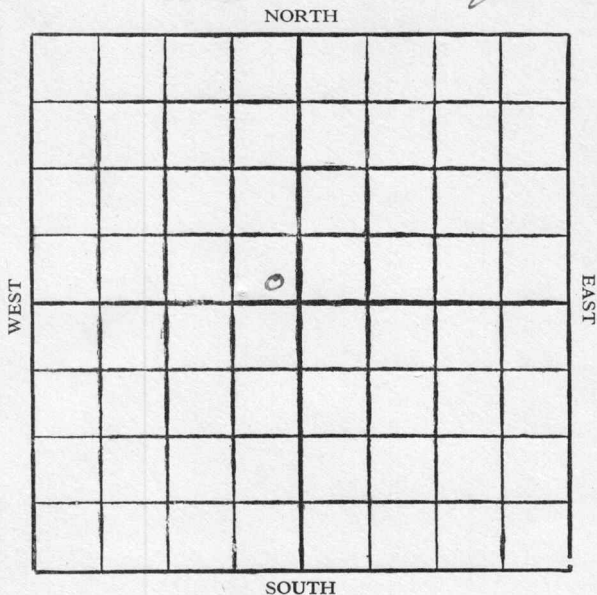

Location

Drilling Remarks

Rig Up

Drilling Remarks

RECORD

Cased in. ft.

Sand

Gas

Oil

Total Depth

PRODUCTION

1st 24 hrs. Nat.

1st 24 hrs. after shot

Gas cu. ft.

Dry Hole

Abandoned

4 KANSAS Map No. Sec. 14 Twp. 31 R. 10^E

Well No. 6 Weleh

Union Gas Co. Company

Contractor

FIRST REPORTS

SECTION PLAT

_____ Ft. from N. Line

200 _____ Ft. from S. Line

200 _____ Ft. from E. Line

_____ Ft. from W. Line

	0		

COMPLETED

Location _____

Rig up _____

Drilling and Remarks:

100 lbs.

RECORD

Cased _____ in., _____ ft.

Sand 1337-1348

Gas _____

Oil _____

Total Depth 1348

PRODUCTION

1st 24 hrs. Nat. _____

1st 24 hrs. after shot. _____

Gas _____ Cu. Ft.

Dry Hole _____

Abandoned _____

Date

JAN 8 1927

CHAS. L. SHERWOOD

192 Scout