

Section 36 Township 15 Range 14-W

Well No. 12 Deines


Company Coralena

Trapp Pool

NORTH

WEST

EAST

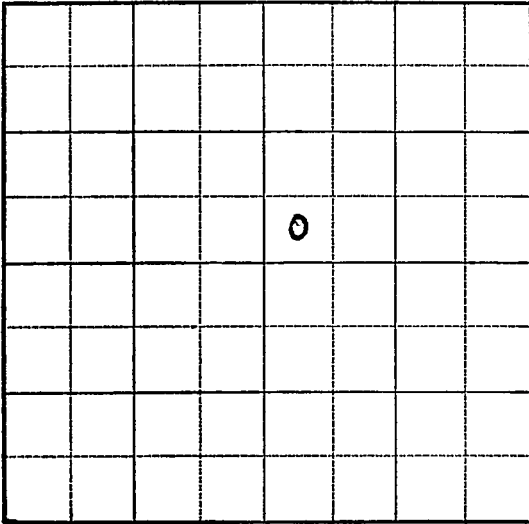

SOUTH

Sec. 36 Twp. 15 R. 14-W

Well No. #12 Deines Farm

Coralena Company

(Trapp)


_____ Ft. from N. Line

330 Ft. from S. Line

_____ Ft. from E. Line

330 Ft. from W. Line

Elev. 1856
~~1876~~

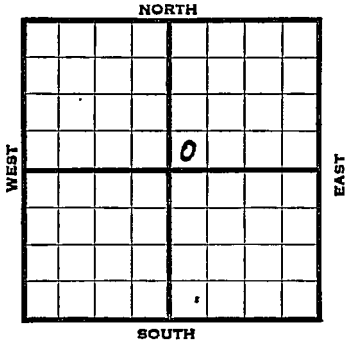

1939	REPORT
5/3	Location
5/12	Cellar.
5/19	Rotary rig.
5/26	10" - 252' Anyh 828' Drig. 2060'
6/1	Topeka 2753' Drig. 3230'
6/7	Arb. 3282
	7" 3282
	T.D. 3292
	2000 acid
	Min. 15 bbls. pump
	COMPLETED

Russell **KANSAS**Map No. 73 Sec. 36 Twp. 15 R. 14WWell No. 12 DeinesCoralena

Company

Contractor

FIRST REPORT**SW NE** Ft. from N. Line330 Ft. from S. Line Ft. from E. Line330 Ft. from W. Line**SECTION PLAT**

		o	

TRAPP POOLLocation XRig up

Drilling and Remarks:

RECORDCased in., ft.Sand Gas Oil Total Depth **PRODUCTION**1st 24 hrs. Nat. 1st 24 hrs. after shot Gas Cu. Ft.Dry Hole Abandoned

Date

MAY 3 1939 19S. J. LEWIS

Scout

Map No. _____ Sec. 36 Twp. 15 R. 14W

Well No. 12 Deines

Coralena

Company.

Contractor

COMPLETED

SECTION PLAT

SW NE

_____ Ft. from N. Line

330 Ft. from S. Line

_____ Ft. from E. Line

330 Ft. from W. Line

TRAPP POOL

Location _____

Rig up _____

Drilling and Remarks:

Cut 3282
7" @ 3282
2000 acid
Min 15886
Pump.

RECORD

Cased _____ in., _____ ft.

Sand _____

Gas _____

Oil _____

Total Depth 3292

PRODUCTION

1st 24 hrs. Nat. _____

1st 24 hrs. after shot _____

Gas _____ Cu. Ft.

Dry Hole _____

Abandoned _____

Date

JUN 7 1939₁₉

S. J. LEWIS

Scout