


Map No. 155 Sec. 14 Twp. 31 R. 10E

Well No. 7-Webb Farm  
Union Gas Corp Company

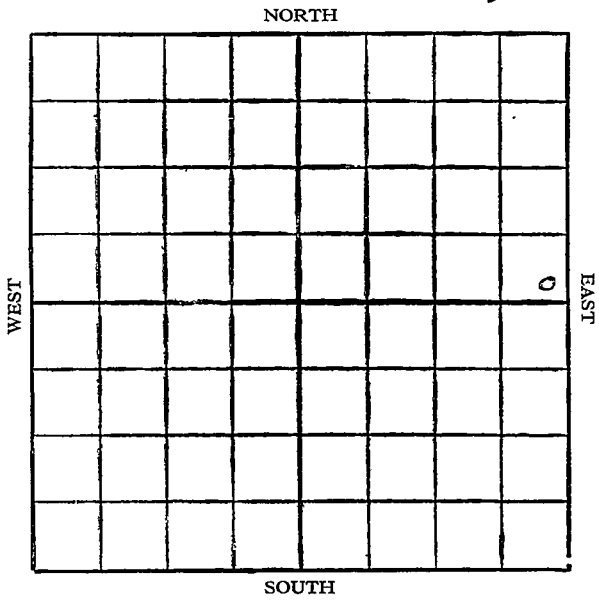

Location .....

Drilling Remarks

.....

.....

**RECORD**

Cased..... in. .... ft.

Sand .....

Gas .....

Oil .....

Total Depth.....

Rig Up.....

Drilling Remarks

.....

.....

**PRODUCTION**

1st 24 hrs. Nat.....

1st 24 hrs. after shot.....

Gas..... cu. ft.

Dry Hole.....

Abandoned.....

ELKS

Map No. Kansas Sec. 14 Twp. 31 R. 10

Well No. 7 Webb Farm  
Union Gas Corp Company


NORTH

..... Ft. from N. Line

200 Ft. from S. Line

200 Ft. from E. Line

..... Ft. from W. Line

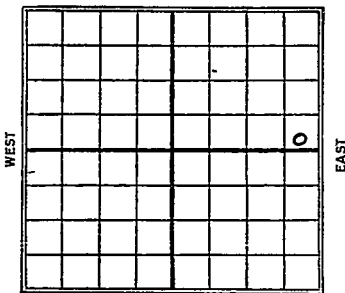

SOUTH

Date  
1927

REPORT

1/8 Sand 1343-1362  
150 bbls

4 KANSAS 925 31  
 Map No. \_\_\_\_\_ Sec. 14 Twp. 31 R. 10<sup>E</sup>  
 Well No. 7 Welch  
 Union Gas Corp Company

Contractor \_\_\_\_\_

**FIRST REPORTS**

**SECTION PLAT**

\_\_\_\_\_ Ft. from N. Line  
 200 \_\_\_\_\_ Ft. from S. Line  
 200 \_\_\_\_\_ Ft. from E. Line  
 \_\_\_\_\_ Ft. from W. Line

			0

**COMPLETED**

Location \_\_\_\_\_  
 Rig up \_\_\_\_\_  
 Drilling and Remarks:

150 lbs.

**RECORD**

Cased \_\_\_\_\_ in., \_\_\_\_\_ ft.  
 Sand 1343-1362  
 Gas \_\_\_\_\_  
 Oil \_\_\_\_\_  
 Total Depth 1362

**PRODUCTION**

1st 24 hrs. Nat. \_\_\_\_\_  
 1st 24 hrs. after shot \_\_\_\_\_  
 Gas \_\_\_\_\_ Cu. Ft.  
 Dry Hole \_\_\_\_\_  
 Abandoned \_\_\_\_\_

Date  
 JAN 8 1927

**CHAS. L. SHERWOOD**

192

Scout