

KANSAS

Russell


Form 51-5M-7-39-Palace

Section 36 Township 15 Range 14-W

Well No. #12 Dumler

Company Shell

NORTH Trapp Pool

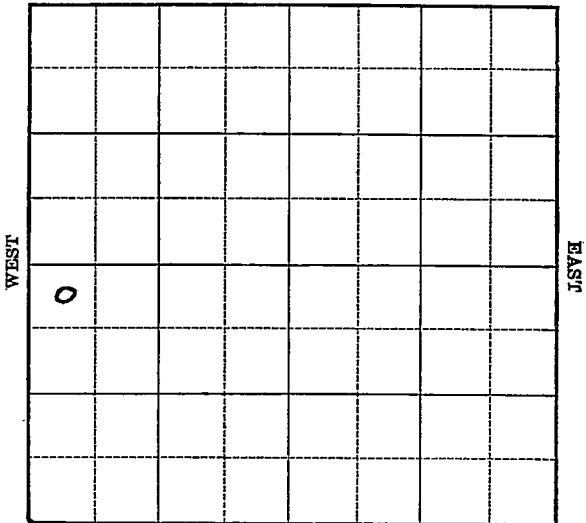

SOUTH

KANSAS

Russell

FORM 252-A 5M 2-40

Sec. 36 Twp. 15 R. 14 -WWell No. #12 Dumler FarmShell Company

(Trapp)


330 Ft. from N. Line

Ft. from S. Line

Ft. from E. Line

330 Ft. from W. Line

Elev. 1895

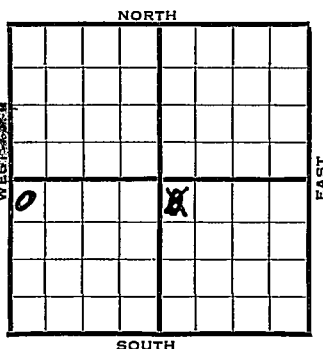

1940.	OFFSET	REPORT
6/5	8" - 628'	WOC.
6/13	Drlg. 2610'	
6/20	Topeka 2797' Arb. 3329'	
	T.D. 3331' 4" - 3329'	RUST.
6/27	T.D. 3335'	1000 acid.
	Swab 319 bbls. in 5 hours.	
7/2	Arb. 3329'	
	4" - 3329'	
	T.D. 3335'	
	1000 acid.	
	Depthograph potential 4633 bbls.	
	Maximum 3000 bbls.	

COMPLETED

Map No. 73 Sec. 36 Twp. 15 R. 14WWell No. 12 DumlerShell

Company

Contractor

FIRST REPORT

NW SW

SECTION PLAT

330 Ft. from N. Line

Ft. from S. Line

Ft. from E. Line

330 Ft. from W. Line

TRAPP POOL

o		X	

Location _____

Rig up _____

Drilling and Remarks:

8" - 628
WOC

OFFSET

RECORD

Cased _____ in., _____ ft.

Sand _____

Gas _____

Oil _____

Total Depth _____

PRODUCTION

1st 24 hrs. Nat. _____

1st 24 hrs. after shot _____

Gas _____ Cu. Ft.

Dry Hole _____

Abandoned _____

Date

JUN 5 1940

S. J. LEWIS

Scout

Map No. 73 Sec. 36 Twp. 15 R. 14WWell No. 12 DumlerShell

Company

Contractor

COMPLETED

NW SW

330 Ft. from N. Line Ft. from S. Line Ft. from E. Line330 Ft. from W. Line

TRAPP POOL

SECTION PLAT

			o
o			

Location Rig up Drilling and Remarks: *Ar & 3329**4" @ 3329**1000 acid**Depthograph PT**4633**May 3000***RECORD**Cased in., ft.Sand Gas Oil Total Depth 3325**PRODUCTION**1st 24 hrs. Nat. 1st 24 hrs. after shot Gas Cu. Ft.Dry Hole Abandoned

Date

JUL 2 1940

19

S. J. LEWIS Scout