

ELK

Map No. Kansas Sec. 14 Twp. 31 R. 10

Well No. 8 Webb Farm
Union Gas Corp Company


NORTH

..... Ft. from N. Line

1320 Ft. from S. Line

200 Ft. from E. Line

..... Ft. from W. Line

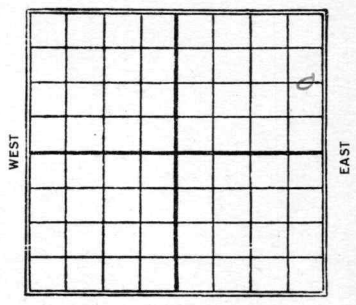

SOUTH

Date

REPORT

1927
1/8

Sand 1318-1332 1/2
60 barrels

4 KANSAS Map No. Sec. 14 Twp. 31 R. 10^E

Well No. 8 Webb

Union S&S Corp. Company

Contractor

FIRST REPORTS

SECTION PLAT

_____ Ft. from N. Line

1320 _____ Ft. from S. Line

200 _____ Ft. from E. Line

_____ Ft. from W. Line

COMPLETED

			⊙

Location _____

Rig up _____

Drilling and Remarks:

60 lbs.

RECORD

Cased _____ in. _____ ft.

Sand 1318-1332 ✓

Gas _____

Oil _____

Total Depth 1332 ✓

PRODUCTION

1st 24 hrs. Nat. _____

1st 24 hrs. after shot _____

Gas _____ Cu. Ft.

Dry Hole _____

Abandoned _____

Date JAN 8 1927

CHAS. L. SHERWOOD

192 Scout