





Sec. 11 26 Twp. 38 Rge. 5

Owner White Eagle Oil Co

Farm Molter Well No. 7

Contractor \_\_\_\_\_

Feet from lines. N \_\_\_\_\_ E \_\_\_\_\_ S 1120 W 200

Casing used \_\_\_\_\_

15 1/2 \_\_\_\_\_ ft.

12 1/2 \_\_\_\_\_ ft.

10 \_\_\_\_\_ ft.


8 1/4 \_\_\_\_\_ ft.

6 5/8 \_\_\_\_\_ ft.

5 3/16 \_\_\_\_\_ ft.

Location R.O.S.

Rig \_\_\_\_\_

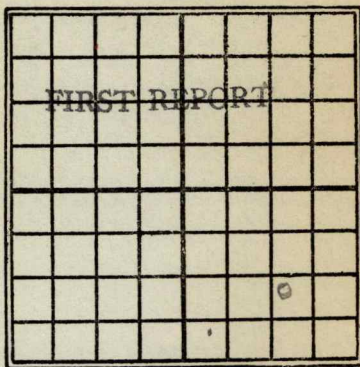

Drilling at \_\_\_\_\_ ft. Fishing at \_\_\_\_\_ ft.

Total Depth \_\_\_\_\_ Completed \_\_\_\_\_

1st 24 Hrs. Nat. \_\_\_\_\_ Producing \_\_\_\_\_

1st 24 Hrs. Shot \_\_\_\_\_ Dry Hole \_\_\_\_\_

Gas \_\_\_\_\_ Cu. ft. Abandoned \_\_\_\_\_

Sands—give name and depth. Top \_\_\_\_\_ Bottom \_\_\_\_\_

2 1/4 Rig

\_\_\_\_\_

\_\_\_\_\_

\_\_\_\_\_

\_\_\_\_\_

\_\_\_\_\_

\_\_\_\_\_

\_\_\_\_\_

\_\_\_\_\_

Date of Report FEB 18 1922

Reported by M. A. BENEAR

Map No. Bas<sup>11</sup> Sec. 26 Twp. 28 R. 5

Well No. 7 Matter

White Eagle Company

Contractor

**COMPLETED**

**SECTION PLAT**

----- Ft. from N. Line

1120 Ft. from S. Line

1120 Ft. from E. Line

----- Ft. from W. Line

			0

Location -----

Rig up -----

Drilling and Remarks:

306 shot

**RECORD**

Cased ----- in., ----- ft.

Sand -----

Gas -----

Oil 2778-95

Total Depth 2793

**PRODUCTION**

1st 24 hrs. Nat. -----

1st 24 hrs. after shot 140

Gas ----- Cu. Ft.

Dry Hole -----

Abandoned -----

Date

JUL 15 1922

----- 191 -----

**M. A. BENEAR**

----- Scout