


Section 27 Township 18 Range 16-W-

Well No. 1 Rodie

Company Moss Petroleum

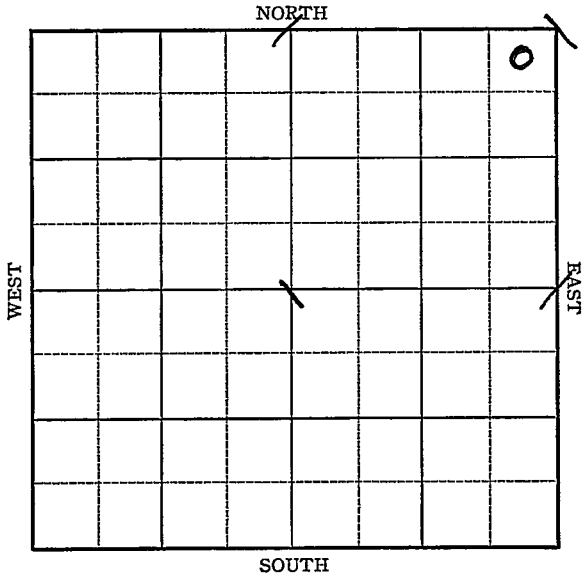


Sec. 27 Twp. 18 R. 16-WWell No. #1 Rodie FarmMoss Petr. Company330 Ft. from N. Line

Ft. from S. Line

330 Ft. from E. Line

Ft. from W. Line

Elev. 1971

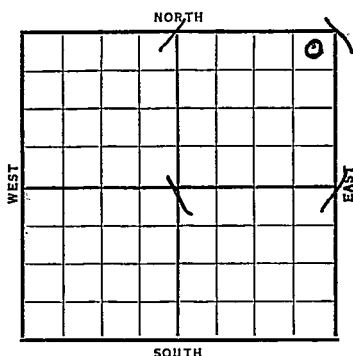

Date

REPORT

1937

11/10 R U R

11/19 15" @ 202'. Drlg. 998'.

11/26 10" @ 1002'. Anhy 1010'.

Drlg. 1240'.

12/3 Drlg. 2900'.

12/10 Cored 3531-48' T.D.

Recovered 15'. 2' shale.

7' gas sand & 6' oil sat.

Regan 3533'. Rng. 8".

12/17 8" @ 3542'. Drlg. 3551'.

12/24 Granite wash 3550'.

Est. $\frac{1}{2}$ M gas 3550-55'.

S.O. 3564-69'. Shot 110 qts.

no increase. T.D. 3599'.

12/31 Granite wash 3577 (Corrected)

 $2\frac{1}{2}$ M gas @ 3586 & S.W.

Granite 3599' T.D.

OVER

1938

1/5

Granite wash 3577'.

Granite 3599'.

T.D. 3599'.

ABANDONED

Rush

KANSAS

Map No. 74 Sec. 27 Twp. 18 R. 16WWell No. 1 RodieMoss Petroleum Company

Contractor

FIRST REPORT

NE/C

330 Ft. from N. Line

_____ Ft. from S. Line

330 Ft. from E. Line

_____ Ft. from W. Line

SECTION PLAT

			0

Location _____

Rig up _____

Drilling and Remarks:

RUR

RECORD

Cased _____ in., _____ ft.

Sand _____

Gas _____

Oil _____

Total Depth _____

PRODUCTION

1st 24 hrs. Nat. _____

1st 24 hrs. after shot _____

Gas _____ Cu. Ft.

Dry Hole _____

Abandoned _____

Date

NOV 10 1937 19

H. D. Hatfield

Scout

Rush **KANSAS**Map No. 74 Sec. 27 Twp. 18 R. 16W,Well No. 1 RodieMoss Petroleum Company

Contractor

ABANDONED
NE/C**SECTION PLAT**

			0

330 Ft. from N. Line

_____ Ft. from S. Line

330 Ft. from E. Line

_____ Ft. from W. Line

Location _____

Rig up _____

Drilling and Remarks:

DVA

RECORD

Cased _____ in., _____ ft.

Sand Granite wash 3577~~Gas~~ Granite 3599

Oil _____

Total Depth 3599**PRODUCTION**

1st 24 hrs. Nat. _____

1st 24 hrs. after shot _____

Gas _____ Cu. Ft.

Dry Hole _____

Abandoned _____

Date

JAN 5 - 1930 19

H. D. Hatfield

Scout