


Map No. 55 Sec. 14 Twp. 29 R. 10

Well No. 11-Webb Farm
Union Gas Corp Company

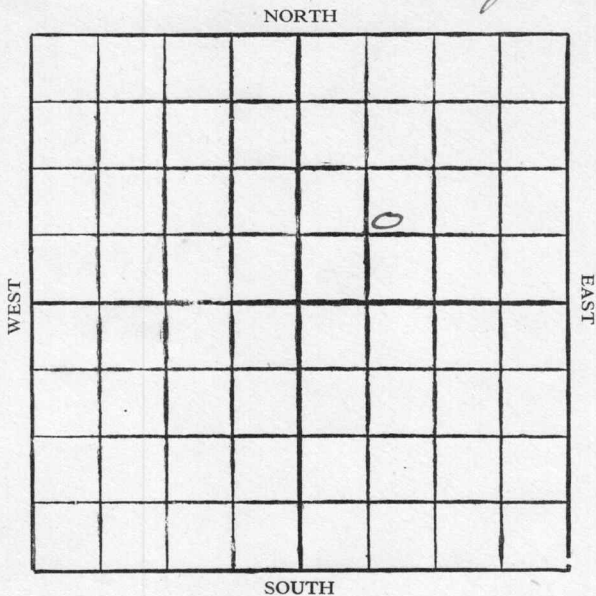

Location

Drilling Remarks

.....

.....

RECORD

Cased in. ft.

Sand

Gas

Oil

Total Depth

Rig Up

Drilling Remarks

.....

.....

PRODUCTION

1st 24 hrs. Nat.

1st 24 hrs. after shot

Gas cu. ft.

Dry Hole

Abandoned

ELK

Map No. Kansas Sec. 14 Twp. 31 R. 10


Well No. 11 Webb Farm
Union Gas Corp Company

..... Ft. from N. Line

785 Ft. from S. Line

..... Ft. from E. Line

785 Ft. from W. Line

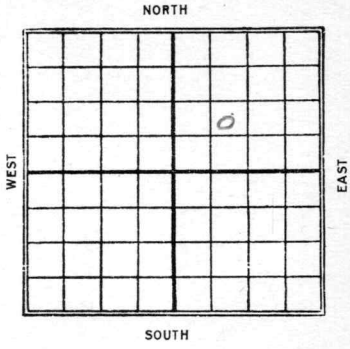

Date
1927

REPORT

1/8 Sand 1332-39
 125 bbls
 38 Gravity

4 KANSAS Sec. 14 Twp. 31 R. 10^E

Well No. 11 Well

Uncon Sec Corp Company

Contractor

FIRST REPORTS

Ft. from N. Line

785 Ft. from S. Line

Ft. from E. Line

785 Ft. from W. Line

COMPLETED

SECTION PLAT

		o	

Location

Rig up

Drilling and Remarks:

125 Bls.
38 Gravity

RECORD

Cased in., ft.

Sand 1332-1339

Gas

Oil

Total Depth 1339

PRODUCTION

1st 24 hrs. Nat.

1st 24 hrs. after shot.

Gas Cu. Ft.

Dry Hole

Abandoned

Date

JAN 8 1927

192

CHAS. L. SHERWOOD

Scout