


Map No. 155 Sec. 14 Twp. 31 R. 10E

Well No. 16-Webb Farm  
Union Gas Corp Company

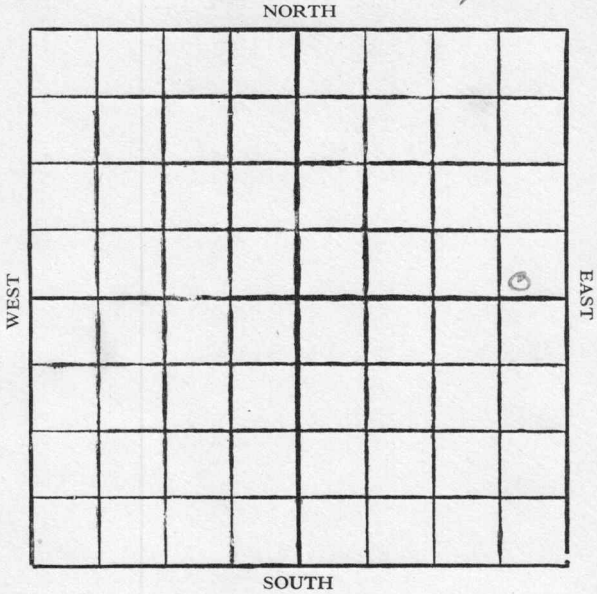

Location .....

Drilling Remarks

.....

.....

**RECORD**

Cased ..... in. .... ft.

Sand .....

Gas .....

Oil .....

Total Depth .....

Rig Up .....

Drilling Remarks

.....

.....

**PRODUCTION**

1st 24 hrs. Nat. ....

1st 24 hrs. after shot .....

Gas ..... cu. ft.


Dry Hole .....

Abandoned .....

Map No. Kansas Sec. 14 Twp. 31 R 10

Well No. 16 Webb Farm \_\_\_\_\_  
Union Gas Company

\_\_\_\_\_ Ft. from N. Line  
500 Ft. from S. Line  
200 Ft. from E. Line  
\_\_\_\_\_ Ft. from W. Line

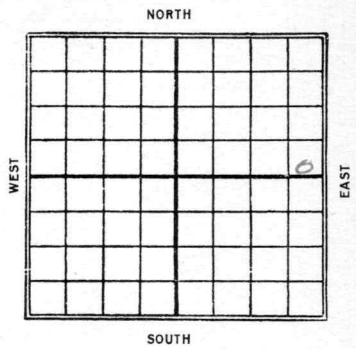

Date  
1927

REPORT

1/8 Sand 1629-34  
300 Oil 37 Gravity

4 KANSAS 62K  
 Map No. \_\_\_\_\_ Sec. 14 Twp. 31 R. 10<sup>E</sup>  
 Well No. 16 Welch  
 Union Gas Corp \_\_\_\_\_ Company

\_\_\_\_\_  
 Contractor

FIRST REPORTS

SECTION PLAT

\_\_\_\_\_ Ft. from N. Line  
 500 \_\_\_\_\_ Ft. from S. Line  
 200 \_\_\_\_\_ Ft. from E. Line  
 \_\_\_\_\_ Ft. from W. Line

			o

COMPLETED

Location \_\_\_\_\_

Rig up \_\_\_\_\_

Drilling and Remarks:

300 lbs.  
 37 gravity

RECORD

Cased \_\_\_\_\_ in., \_\_\_\_\_ ft.  
 Sand 1629-1634  
 Gas \_\_\_\_\_  
 Oil \_\_\_\_\_  
 Total Depth 1634

PRODUCTION

1st 24 hrs. Nat. \_\_\_\_\_  
 1st 24 hrs. after shot \_\_\_\_\_  
 Gas \_\_\_\_\_ Cu. Ft.  
 Dry Hole \_\_\_\_\_  
 Abandoned \_\_\_\_\_

Date

JAN 8 1927

CHAS. L. SHERWOOD

192

Scout