


Map No. Kansas Sec. 14 Twp. 31 R. 10

Well No. 17 Webb Farm
Union Gas Company

NORTH

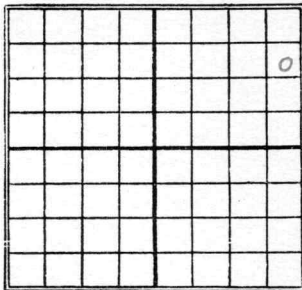

WEST

EAST

SOUTH

..... Ft. from N. Line

1590 Ft. from S. Line

250 Ft. from E. Line

..... Ft. from W. Line

Date

REPORT

1927

1/8

Sand 1607-1616
75 bbls

4 KANSAS Map No. Sec. 14 Twp. 31 R. 10^W

Well No. 17 Wellh
Union Gas Corp Company

Contractor

FIRST REPORTS

SECTION PLAT

Ft. from N. Line

1590

Ft. from S. Line

250

Ft. from E. Line

Ft. from W. Line

COMPLETED

			0

Location

Rig up

Drilling and Remarks:

75 lbs.

RECORD

Cased 1607 in., 1616 ft.

Sand 1607-1616

Gas

Oil

Total Depth 1616

PRODUCTION

1st 24 hrs. Nat.

1st 24 hrs. after shot

Gas Cu. Ft.

Dry Hole

Abandoned

Date

JAN 8 1927

CHAS. L. SHERWOOD

192

Scout