


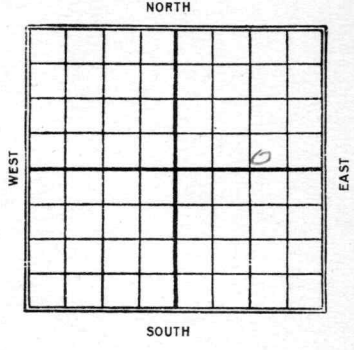

Map No. Kansas Sec. 14 Twp. 31 R. 10

Well No. 18 Webb Farm  
Union Gas Corp Company

..... Ft. from N. Line  
250 Ft. from S. Line  
1235 Ft. from E. Line  
..... Ft. from W. Line



Date  
1926

REPORT

1/8 Sand 1616-33 1/2 200 bbls

4 KANSAS <sup>Rel</sup> Map No. Sec. 14 Twp. 31 R. 10<sup>E</sup>

Well No. 18 Welch

Union S&S Corp Company

Contractor

FIRST REPORTS

SECTION PLAT

----- Ft. from N. Line

250 Ft. from S. Line

1235 Ft. from E. Line

----- Ft. from W. Line

COMPLETED

			o

Location -----

Rig up -----

Drilling and Remarks:

200 lbs.

RECORD

Cased 1616 in., 1633 1/2 ft.

Sand 1616-1633 1/2

Gas -----

Oil -----

Total Depth 1633 1/2

PRODUCTION

1st 24 hrs. Nat. -----

1st 24 hrs. after shot. -----

Gas ----- Cu. Ft.

Dry Hole -----

Abandoned -----

Date

JAN 8 1927

CHAS. L. SHERWOOD