


*Kansas*

Map No. \_\_\_\_\_ Sec. *26* Twp. *28* R. *5*

Well No. *4 Moulter S 40 A* Farm \_\_\_\_\_

*Natl. Rejig* Company \_\_\_\_\_

NORTH

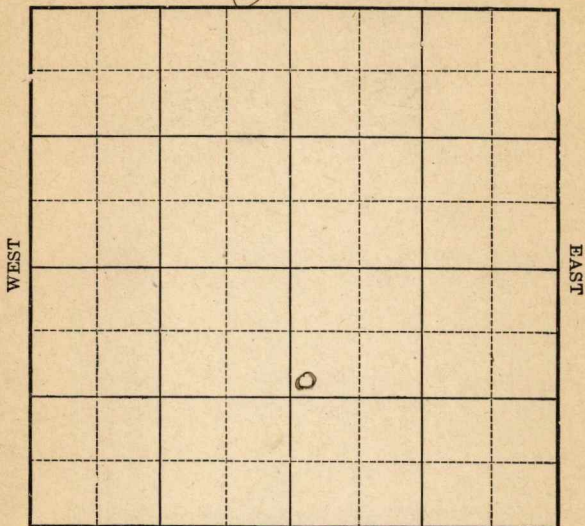

SOUTH

Location \_\_\_\_\_

Drilling Remarks: \_\_\_\_\_  
\_\_\_\_\_  
\_\_\_\_\_  
Rig Up \_\_\_\_\_

Drilling Remarks: \_\_\_\_\_  
\_\_\_\_\_  
\_\_\_\_\_  
RECORD

Cased \_\_\_\_\_ in. \_\_\_\_\_ ft.

Sand \_\_\_\_\_

Gas \_\_\_\_\_

Oil \_\_\_\_\_

Total Depth \_\_\_\_\_

PRODUCTION

1st 24 hrs. Nat. \_\_\_\_\_

1st 24 hrs. after shot \_\_\_\_\_

Gas \_\_\_\_\_ cu. ft.

Dry Hole \_\_\_\_\_

Abandoned \_\_\_\_\_



Map No. 11 Kan 26 Sec. 26 Twp. 28 R. 5  
 Well No. 4 Maunter S. 400.  
Natl' Rigg. Company \_\_\_\_\_ Contractor \_\_\_\_\_

FIRST REPORT

----- Ft. from N. Line  
 ----- Ft. from S. Line  
 ----- Ft. from E. Line  
 ----- Ft. from W. Line

SECTION PLAT


Location -----  
 Rig up -----  
 Drilling and Remarks:

*Rigg & Bldg.*

RECORD

Cased ----- in., ----- ft.  
 Sand -----  
 Gas -----  
 Oil -----  
 Total Depth -----

PRODUCTION

1st 24 hrs. Nat. -----  
 1st 24 hrs. after shot -----  
 Gas ----- Cu. Ft.  
 Dry Hole -----  
 Abandoned -----

Date

MAY 21 1922

**M. A. DENBAR**

191

Scout

Map No. Kan 11 26 Sec. 26 Twp. 28 R. 5

Well No. 4 mlt. S. 40 A.  
Natl Refg. \_\_\_\_\_ Company \_\_\_\_\_

Contractor \_\_\_\_\_

**COMPLETED**

**SECTION PLAT**

1120 Ft. from N. Line

\_\_\_\_\_ Ft. from S. Line

**COMPLETED** \_\_\_\_\_ Ft. from E. Line

200 Ft. from W. Line

		0	

Location \_\_\_\_\_

Rig up \_\_\_\_\_

Drilling and Remarks:

10 gts a hit,

**RECORD**

Cased \_\_\_\_\_ in., \_\_\_\_\_ f

Sand \_\_\_\_\_

Gas \_\_\_\_\_

Oil 2788-2806

Total Depth 2806.

**PRODUCTION**

1st 24 hrs. Nat. \_\_\_\_\_

1st 24 hrs. after shot 192

Gas \_\_\_\_\_ Cu. F

Dry Hole \_\_\_\_\_

Abandoned \_\_\_\_\_

Date \_\_\_\_\_

JUL 22 1922

M. A. BENEAR