


Rush

KANSAS

SECTION 27 TOWNSHIP 18S RANGE 16W

WELL NO. #2-Peter Rodie

COMPANY Skelly Oil

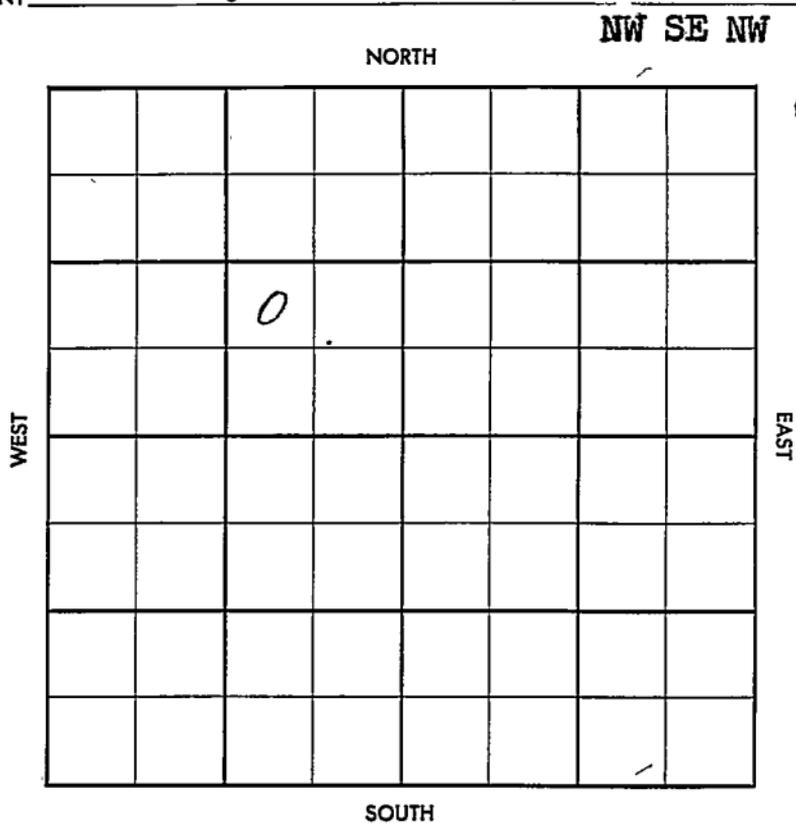

County Rush Elev. _____
 Sec. 27 Twp. 18 Rge. 16W
 Company Skelly Oil
 Farm Name Peter Rodie No. 2

TOPS	DEPTH	LOG	DATUM
Anb.			
Tp.			
H.			
Tr.			
Dg.			
Bl.			
L.			
K.C.			
B.K.C.			
Ce.			
C.			
M.			
M.			
K.			
Mz.			
Me.			
V.			
S.			
S.			
A			
R.			
Pe.			
G.			
T.D.			

Loc. in Sec. _____
NW SE NW
 Geol. _____
 Contr. _____
Wentworth
 Pool _____
Otis-Albert

FIRST REPORT
 0
 JUL 17 '57

Date Comm. _____
 Location _____

~~14~~

Co.
Lse.
No.
Sec.
T.
R.

 Company Shelly Oil
 Farm Name Peter Rodie No. 2

TOPS	DEPTH	LOG	DATUM	Loc. in Sec.
Anb.	1035			NW ST, NW
Tr.	3225			
Dg. <u>sd</u>	3242			
Bl.	3264			
L.	3284			Geol.
K.C.				Contr.
B.K.C.	3511			Wentworth
Ce.				Pool
C.	3559			Otis-Albert
M.				
M.				
K.				
Mz.				
Me.				
V.				
S.				
S.				
A.				
R. <u>sd</u>	3583			<div style="border: 1px solid black; padding: 5px; text-align: center;"> AUG 21 '57 COMPLETE </div>
PE. <u>Q57</u>	3659			
G.				
TD.	3683			

Date Comm.

Location JUL 24 '57 7-16-57 858
1047/500 D 2140 JUL 31 '57 DST
3281-3325 1hr run 210' MW FP
0-92 BHP 1340/20" DST 3579
-3617 1hr 6 1/2" ga 734 MCF run
105' HO 6" GCM + 450' oil + 15' wt
840/30" AUG 8 '57 crd 3619-37 run
17' DST 3617-30 1hr 300' 6" GCM
+ 50' oily wtg Md + 820' SW BHP

900/38^W Rng 5 1/2 @ AUG 25⁸⁸
 5 1/2 @ 3682/125 CO 3671
 LWL 24/3615-20 1/2 \$ 80
 BW in 6 hrs 54d PB 3608
 15/3595-98 \$ 360 + 26 wph
 3 hrs 42/3588-95 9.0 150
 MCF 6/5" \$ 131 130 n/w
 16 hrs ^{21 58} PF 185 3585-88 \$ 3680 +
 TX/5 hrs 620 167 MCF 125 3583-85 \$ 3680 +
 TX/5 hrs 620 167 MCF PBTD 3608 11 +
 Pp 160 B0/24 hr + 0 X
 Req sd 3583-88