

Rush

KANSAS

27


18

16W

SECTION \_\_\_\_\_ TOWNSHIP \_\_\_\_\_ RANGE \_\_\_\_\_

WELL NO. #1 Peter Rodie

COMPANY Skelly Oil Co.

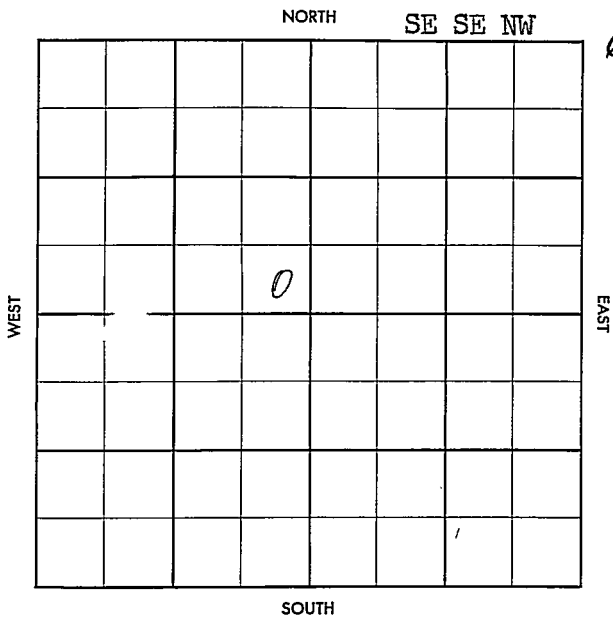



Co.

Log.

No.

Sec.

T.

R

County Rush Elev. 1991  
 Sec. 27 Twp. 18 Rge. 16W  
 Company Skelly Oil Co.  
 Farm Name Peter Rodie No. 1

TOPS	DEPTH	LOG	DATUM	Loc. in Sec.
Anb.	1039			SE SE 1/4
Tr.				
H.	3234			
Tr.	3250			
Dg.				
Bl.				
L.	3296			
K.C.				Geol.
B.K.C.				Contr.
Ce.				Wentworth Tl
C.				
M.				Pool
M.				Otis-Albert
K.				
Mz.				
Mo.				
V.				
S.				
S.				
A.				
R. sd	3588			<div style="border: 1px solid black; padding: 5px; text-align: center;"> <p>JUN 26 '57</p> <p>o</p> <p>COMPLETE</p> </div>
PE.	3669			
G.				
TD.	3680			

Date Comm. \_\_\_\_\_  
 Location 14-1-57  
8578 1050/500 N 2350  
CRD 3591-3628 DST 3593-  
3628 1 in 6" ga 734 MFLW  
rec 35' HO'E' GCM + 60' 58'E' GCM  
+ 120' HO'E' GCM + 180' 1'E' WCM  
FP 145-180 BHP 720 APR 24 '57  
DST 3628-59 1 in rec 230'  
HO'E' GCM + 420' S only W.M +

1210' SW BHP 935' 20" 5 1/2  
 3679/125 MAY 1 '57 CO 3671 PF  
 25/3637-41 \$ 40 BW in 15  
 hrs 53d P. 3 3633 55/  
 3623-32 \$ 16 B0 + 41 BW  
 in 15 hrs P. B 3610 25/3598  
 -3602 B \$ 50 + 1 Gwph 3 hrs  
 + 75 MCFG 18/3595-98  
 \$ 18 50 + 1 Gwph 8 hrs  
 + 155 MCFG, 11/2 \$ 6 B0 +  
 6 B Acid wt in 17 hrs +  
 734 MCFG FRAC \$ 297 BW  
 10 12 hrs 599 (3592-3602)  
 CO 3599 25/3592-96  
 B 10 GW in 1 hr 12/3596  
 -98 B 10 Gwph 2 hrs 1/2  
 \$ 14 B0 + 21 BW 12 hrs  
 MAY 22 '57 MAY 29 '57 P. 42  
 B0 + 4 BW 24 hrs P. 17  
 WSPD + 4 BW 24 hrs JUN 5 '57  
 24/3586-89 1/2 + 5 + 3  
 B0 + 5 BW 24 hrs 51 P.  
 16 B0 + 3 1/2 BW 24 hrs  
 P. 11 B0 + 2 BW 24 hrs  
 VISO FRAC \$ 43 B0 + 7  
 BW in 6 hrs \$ 92 B0 +  
 35 BW 24 hrs POT JUN 7 '57  
 P. 18 B0 + 32 BW 24 hrs  
 MAY 26 '57 P. 30 B0pd + 32 BWpd