


Map No. 175 Sec. 15 Twp. 31 R. 10
 Well No. 1- Ames Farm
Croft et al Company

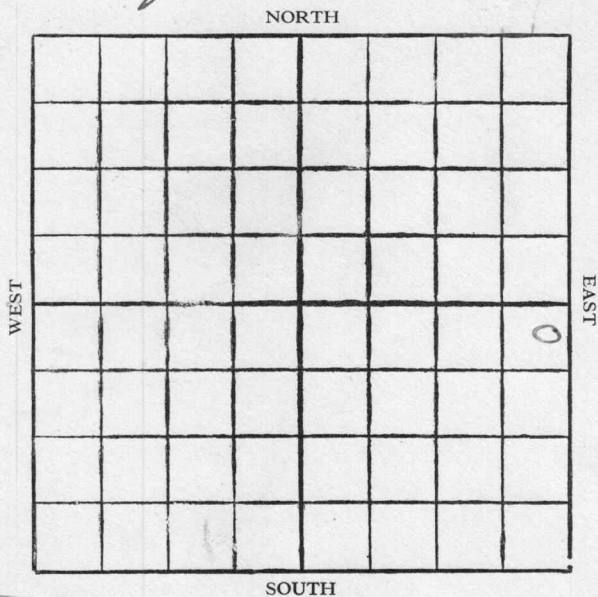

Location

Drilling Remarks

.....

.....

Rig Up.....

Drilling Remarks

.....

.....

.....

.....

.....

.....

.....

.....

.....

.....

.....

.....

.....

.....

.....

.....

RECORD

Cased..... in. ft.

Sand

Gas

Oil

Total Depth.....

PRODUCTION

1st 24 hrs. Nat.

1st 24 hrs. after shot.....

Gas..... cu. ft.

Dry Hole

Abandoned

ELK

Map No. Kansas Sec. 15 Twp. 31 R. 10


Well No. 1 Ames Farm
Croft et al Company

250 Ft. from N. Line

_____ Ft. from S. Line

250 Ft. from E. Line

_____ Ft. from W. Line

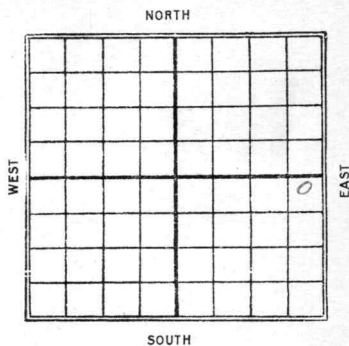

Date

REPORT

1927

1/8

Gas sand 1095-1105
Abandoned 1405

665
 4 KANSAS
 Map No. _____ Sec. 15 Twp. 31 R. 10
 Well No. 1 lines

010 ft et al Company _____

Contractor _____

FIRST REPORTS

250 _____ Ft. from N. Line

_____ Ft. from S. Line

250 _____ Ft. from E. Line

_____ Ft. from W. Line

COMPLETED

SECTION PLAT

	ABANDONED		
			o

Location _____

Rig up _____

Drilling and Remarks:

500 Sand

1095-1105

RECORD

Cased _____ in., _____ ft.

Sand _____

Gas _____

Oil _____

Total Depth 1405

PRODUCTION

1st 24 hrs. Nat. _____

1st 24 hrs. after shot _____

Gas _____ Cu. Ft.

Dry Hole ✓ _____

Abandoned ✓ _____

Date

JAN 8 1927

192 _____ Scout

CHAS. L. SHERWOOD