



Map No. \_\_\_\_\_ Sec. 27 Twp. 28 R. 25


Well No. 1 Allen Farm \_\_\_\_\_  
Ramsey Loyd Company \_\_\_\_\_

\_\_\_\_\_ Ft. from N. Line

200 Ft. from S. Line

200 Ft. from E. Line

\_\_\_\_\_ Ft. from W. Line

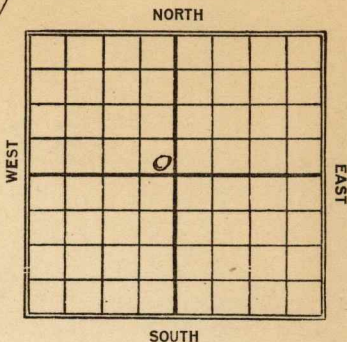

Date

REPORT

1922

9/16

Rig.

11/24

DDG 2947'

Map No. **KANSAS** Sec. **27** Twp. **28** R. **5**

Well No. **1 alley**

**Ramsay Lloyd** Company Contractor

### FIRST REPORT

### SECTION PLAT

----- Ft. from N. Line  
**200**  
----- Ft. from S. Line  
**200**  
----- Ft. from E. Line  
----- Ft. from W. Line

		o	

Location -----

Rig up **L L** -----

Drilling and Remarks:

### RECORD

Cased ----- in., ----- ft.  
Sand -----  
Gas -----  
Oil -----  
Total Depth -----

### PRODUCTION

1st 24 hrs. Nat. -----  
1st 24 hrs. after shot -----  
Gas ----- Cu. Ft.  
Dry Hole -----  
Abandoned -----

Date

**SEP 16 1922** 191 -----

**M. A. BENEAR** Scout

Map No. **KANSAS** Sec. **27** Twp. **28** R. **5**

Well No. **R 1 Allen**

**Ramsey Lloyd** Company

Contractor

SECTION PLAT

**ABANDONED**

		0	

Ft. from N. Line

**200** Ft. from S. Line

**200** Ft. from E. Line

Ft. from W. Line

Location -----

Rig up -----

Drilling and Remarks:

RECORD

Cased ----- in., ----- ft.

Sand -----

Gas -----

Oil -----

Total Depth -----

PRODUCTION

1st 24 hrs. Nat. -----

1st 24 hrs. after shot -----

Gas ----- Cu. Ft.

Dry Hole -----

Abandoned **2947**

Date

NOV 24 1922

M. A. BENEAR

191

Scout