


Elk

Map No. KANSAS Sec. 15 Twp. 31 R. 10^E
Well No. 3 - Elston Farm
Denton et al Company

700 Ft. from N. Line
_____ Ft. from S. Line
_____ Ft. from E. Line
1070 Ft. from W. Line

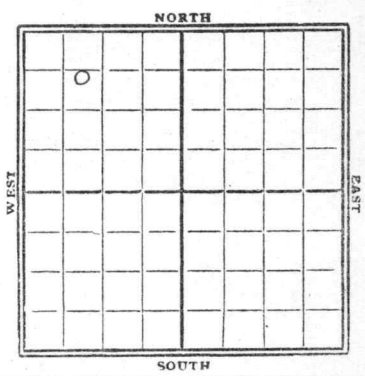

1929

Date REPORT

Date	REPORT
7/10	Run up.
7/17	Sp dy.
7/24	" " 300'
7/31	Drily 1220'
8/7	" " 1775'
8/14	Top line 1985-2022' shot 120 gtr 150 bbl 1st 24 hours.
8/21	same 1985-2022' J.D. 2022' shot 120 gtr 150 bbl oil Comp.

Elk

4 Map No. **KANSAS** Sec. 15 Twp. 31 R. 10^E

Well No. 3 *Elston*
Denton et al Company _____

Contractor _____

FIRST REPORTS

700 Ft. from N. Line
_____ Ft. from S. Line
_____ Ft. from E. Line
1070 Ft. from W. Line

SECTION PLAT

0			

Location _____

Rig up _____

Drilling and Remarks:

Rigging up

RECORD

Cased _____ in., _____ ft.
Sand _____
Gas _____
Oil _____
Total Depth _____

PRODUCTION

1st 24 hrs. Nat. _____
1st 24 hrs. after shot _____
Gas _____ Cu. Ft.
Dry Hole _____
Abandoned _____

Date

7/10/29 19

CHAS. L. SHERWOOD

Scout

4 **KANSAS** *Elk*
 Map No. _____ Sec. 15 Twp. 31 R. 10

Well No. 3 Elston
Denton oral _____ Company _____

Contractor _____

COMPLETE

SECTION PLAT

700 Ft. from N. Line
 _____ Ft. from S. Line
 _____ Ft. from E. Line
1070 Ft. from W. Line

0			

Location _____

Rig up _____

Drilling and Remarks:

t. line 1985

120/150 R/S

RECORD

Cased _____ in., _____ ft.

Sand 1985-2022'

Gas _____

Oil _____

Total Depth 2022'

PRODUCTION

1st 24 hrs. Nat. _____

1st 24 hrs. after shot _____

Gas _____ Cu. Ft.

Dry Hole _____

Abandoned _____

Date

8/21

19 *29*

CHAS. L. SHERWOOD

Scout