

Map No. *Blk* **KANSAS** Sec. *15* Twp. *31* R. *10*

Well No. *3 - Elstun* Farm


Denton *Coal* Company

100 Ft. from N. Line

..... Ft. from S. Line

1020 Ft. from E. Line

..... Ft. from W. Line

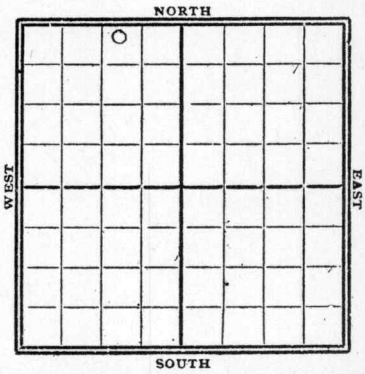

1929

Date

REPORT

Date	REPORT
<i>1/9</i>	<i>Spdg.</i>
<i>1/16</i>	<i>drlg 525'</i>
<i>1/23</i>	<i>" 1275'</i>
<i>1/30</i>	<i>" 1970'</i>
<i>2/6</i>	<i>sand 1979-2014'</i>
	<i>TD. 2014'</i>
	<i>shot 100 gts</i>
	<i>65 bbl oil</i>
	<i>Pump</i>

K4 MAP NO. KANSAS SEC. 15 TWP. 31 R. 10

WELL No. 3 *Elstun*
Denton et al COMPANY

CONTRACTOR

FIRST REPORT

SECTION PLAT

100 FT. FROM N. LINE
____ FT. FROM S. LINE
1070 FT. FROM E. LINE
____ FT. FROM W. LINE

	0		

LOCATION _____
RIG UP _____
DRILLING AND REMARKS: *Spdy*

RECORD

CASED _____ IN. _____ FT.
SAND _____
GAS _____
OIL _____
TOTAL DEPTH _____

PRODUCTION

1ST 24 HRS. NAT. _____
1ST 24 HRS. AFTER SHOT _____
GAS _____ CU. FT.
DRY HOLE _____
ABANDONED _____

DATE
JAN 9 1929

CHAS. L. SHERWOOD
192 _____ SCOUT

Elk 31

Map No. *H4* **KANSAS** Sec. *15* Twp. *31* R. *10*

Well No. *3 Elkstem*

Denton Oil Company

Contractor

COMPLETE

SECTION PLAT

	0		

100 Ft. from N. Line

Ft. from S. Line

1070 Ft. from E. Line

Ft. from W. Line

Location

Rig up

Drilling and Remarks:

100/65 Pk.

RECORD

Cased _____ in., _____ ft.

Sand *1979-2014*

Gas _____

Oil _____

Total Depth *2014*

PRODUCTION

1st 24 hrs. Nat. _____

1st 24 hrs. after shot _____

Gas _____ Cu. Ft.

Dry Hole _____

Abandoned _____

Date

FEB 6 1929

CHAS. L. SHERWOOD

192 _____ Scout