

Map No. KANSAS Sec. 15 Twp. 31 R. 10


Well No. 2-Elstrun Farm
Wenton et al Company

250 Ft. from N. Line

..... Ft. from S. Line

..... Ft. from E. Line

1070 Ft. from W. Line

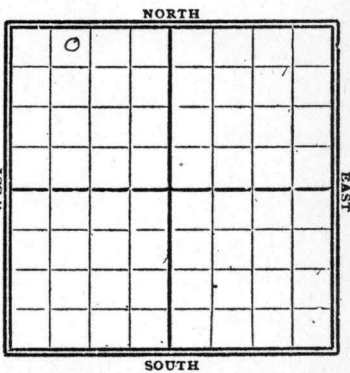

1928

Date

REPORT

10/31	Location
11/17	2' rlg 800'
11/14	" 1460'
11/21	sand 1982-2015' shot 140 gts, 9ly out
11/28	sand 1982-2015' TD 2015' shot 140 gts 140 bbls oil Pump.

Elk

K9 KANSAS SEC. 15 TWP. 31 R. 10

MAP No. _____
 WELL No. 2 *Elstun*
Denton et al COMPANY

CONTRACTOR _____

FIRST REPORTS

250 FT. FROM N. LINE
 _____ FT. FROM S. LINE
 _____ FT. FROM E. LINE
1070 FT. FROM W. LINE

SECTION PLAT

0			

LOCATION ✓ _____

RIG UP _____

DRILLING AND REMARKS:

RECORD

CASED _____ IN., _____ FT.
 SAND _____
 GAS _____
 OIL _____
 TOTAL DEPTH _____

PRODUCTION

1ST 24 HRS. NAT. _____
 1ST 24 HRS. AFTER SHOT _____
 GAS _____ CU. FT.
 DRY HOLE _____
 ABANDONED _____

DATE

OCT 31 1928

CHAS. L. SHERWOOD

192

SCOUT

K4 KANSAS

MAP NO. _____ SEC. 15 TWP. 31 R. 10

WELL NO. 2 Belstun

Denton et al

COMPANY _____

CONTRACTOR _____

COMPLETED

SECTION PLAT

0			

250 FT. FROM N. LINE

_____ FT. FROM S. LINE

_____ FT. FROM E. LINE

1070 FT. FROM W. LINE

LOCATION _____

RIG UP _____

DRILLING AND REMARKS:

140/140 Abs.

RECORD

CASED _____ IN. _____ FT.

SAND 1982-2015

GAS _____

OIL _____

TOTAL DEPTH 2015

PRODUCTION

1ST 24 HRS. NAT. _____

1ST 24 HRS. AFTER SHOT _____

GAS _____ CU. FT.

DRY HOLE _____

ABANDONED _____

DATE

NOV 28 1928

CHAS. L. SHERWOOD

192

SCOUT