

KANSAS

Rush county

Sec. 27 Twp. 18 R. 16W

Well No. 1 Roth Farm

Coppinger etal Company


Wildcat

330 Ft. from N. Line

_____ Ft. from S. Line

330 Ft. from E. Line

_____ Ft. from W. Line

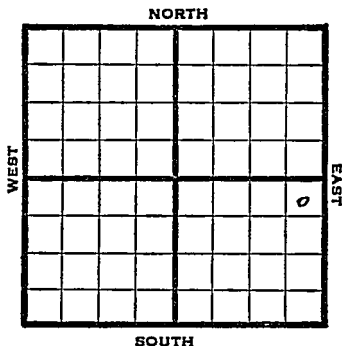

NE SE

1947 **Elev. 1974** REPORT

5/7 Location

5/13 "

5/20 "

5/27 8" @ 1040'
WOC

6/3 Drlg 2903

6/10 Reagan 3598
TD 3605
5" @ 3598
RUST

6/17 TD 3606 CO

6/25 TD 3622'
Reagan 3598'
Abandoned

ABANDONED

Map No. K 74 Sec. 1 Twp. 18 R. 16W

Well No. 1 Roth

Coppinger etal. Company

FIRST REPORT Contractor

NE SE

SECTION PLAT

330 Ft. from N. Line

 Ft. from S. Line

330 Ft. from E. Line

 Ft. from W. Line

Rush County

Location X

Rig up

Drilling and Remarks:

RECORD

Cased in., ft.

Sand

Gas

Oil

Total Depth

PRODUCTION

1st 24 hrs. Nat.

1st 24 hrs. after shot

Gas Cu. Ft.

Dry Hole

Abandoned

Date

MAY 7 1947 19

S. J. LEWIS Scout

Map No. k 74 Sec. 27 Twp. 18 R. 16W

Well No. 1 Roth

Coppinger et al. Company

CORRECTION Contractor

NE SE

SECTION PLAT

330 Ft. from N. Line

 Ft. from S. Line

330 Ft. from E. Line

 Ft. from W. Line

			o

Rush County

Location

Rig up

Drilling and Remarks:

Reported in
1-18-16W

RECORD

Cased in., ft.

Sand

Gas

Oil

Total Depth

PRODUCTION

1st 24 hrs. Nat.

1st 24 hrs. after shot

Gas Cu. Ft.

Dry Hole

Abandoned

Date

MAY 14 1947 19

S. J. LEWIS

Scout

