


Kansas

Map No. _____ Sec. 27 Twp. 28 R. 5

Well No. 2 Hoise Farm _____

Elwell Etal Company _____

NORTH

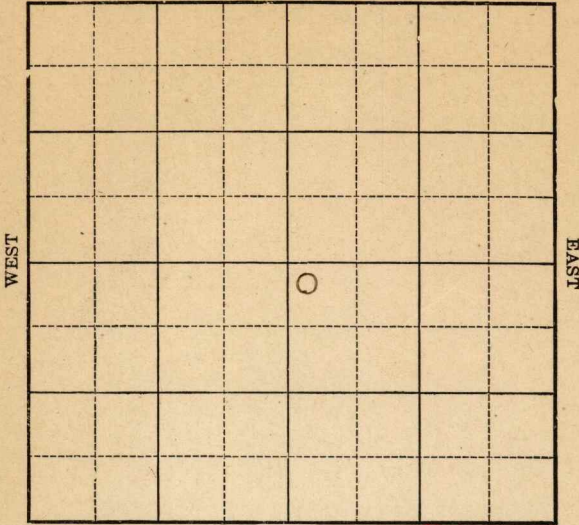

FIRST REPORT

Location _____

Drilling Remarks:

Rig Up **COMPLETED**

Drilling Remarks:

RECORD

Cased _____ in. _____ ft.

Sand _____

Gas _____

Oil _____

Total Depth _____

PRODUCTION

1st 24 hrs. Nat. _____

1st 24 hrs. after shot _____

Gas _____ cu. ft.

Dry Hole _____

Abandoned _____

Map No. _____ Sec. 27 Twp. 28 R. 5


Well No. 2 House Farm _____
Elwell Etal Company _____

200 Ft. from N. Line

_____ Ft. from S. Line

_____ Ft. from E. Line

200 Ft. from W. Line

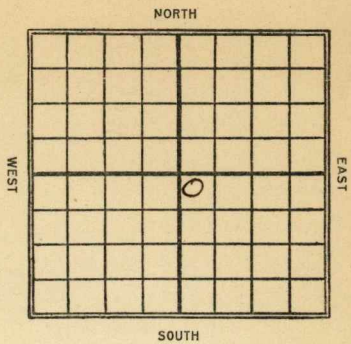

Date
7/22

REPORT

10/20 Spud.
11/24 Sand 2660-78 - Shot 20
gts. 70 Bbls.

Map No. **KANSAS** 11 Sec. 27 Twp. 28 R. 5

Well No. 2 Hayse
E. Swell et al Company

Contractor

FIRST REPORT

SECTION PLAT

200 Ft. from N. Line

----- Ft. from S. Line

----- Ft. from E. Line

200 Ft. from W. Line

		o	

Location -----

Rig up -----

Drilling and Remarks:

spud

RECORD

Cased ----- in., ----- ft.

Sand -----

Gas -----

Oil -----

Total Depth -----

PRODUCTION

1st 24 hrs. Nat. -----

1st 24 hrs. after shot -----

Gas ----- Cu. Ft.

Dry Hole -----

Abandoned -----

Date

OCT 26 1922

M. A. BENEAR

191

Scout

Map No. **KANSAS** Sec. *27* Twp. *28* R. *5*

Well No. *2* *Hansen*
E. Lowell et al. Company

Contractor

COMPLETED SECTION PLAT

200' Ft. from N. Line
 ----- Ft. from S. Line
 ----- Ft. from E. Line
200' Ft. from W. Line

		0	

Location -----

Rig up -----

Drilling and Remarks:

shot 20 gtb

RECORD

Cased ----- in., ----- ft.
 Sand -----
 Gas -----
 Oil *2660-78*
 Total Depth *2678*

PRODUCTION

1st 24 hrs. Nat. -----
 1st 24 hrs. after shot *70*
 Gas ----- Cu. Ft.
 Dry Hole -----
 Abandoned -----

Date

NOV 24 1922 *191*

M. A. BENEAR

Scout