

KANSAS

Rush

Section 28 Township 18 Range 16WWell No. 1 Wagoner (Wagner)Company Ben Brack & Phillips

Wildcat

NORTH

WEST

EAST

SOUTH

0

14

KANSAS

Rush

Sec. 28 Twp. 18 R. 16W

Well No. #1 Wagoner Farm

Ben Brack & Phillips Company

Wildcat

 Ft. from N. Line

330'


 Ft. from S. Line

330'

 Ft. from E. Line

 Ft. from W. Line

.SE SW

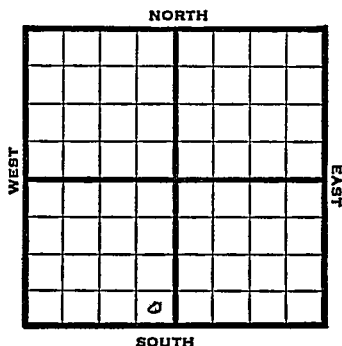

1948

Elev. 2044' REPORT

9/8 Surface hole

9/14 8" @ 761'

Drlg 2360'

9/21 Lansing 3368'

Reagan 3659' - 65'

TD 3665'

9/29 Lans 3368'

Reagan 3639' - 1595'

TD 3681'

ABANDONED

Map No. 74 Sec. 28 Twp. 18 R. 16WWell No. 1 WagnerBen Brack & Phillips Company**ABANDONED**

Contractor

SE SW

E12044
SECTION PLAT Ft. from N. Line330 Ft. from S. Line330 Ft. from E. Line Ft. from W. Line

Rush CountyLocation Rig up

Drilling and Remarks:

Lions 3368
Reagan 3639

RECORD

Cased in., ft.Sand Gas Oil Total Depth 3687

PRODUCTION

1st 24 hrs. Nat. 1st 24 hrs. after shot Gas Cu. Ft.Dry Hole Abandoned

Date

SEP 29 194819S. J. LEWISScout

Rush County Kansas State

Map No. _____ Sec. 28 Twp. 18 R. 16W

Well No. 1 Wagoner

Ben Brack & Phillips Company

FIRST REPORT **Contractor**

SE SW

SECTION PLAT


Ft. from N. Line

330 Ft. from S. Line

330 Ft. from E. Line

_____ Ft. from W. Line

Wildcat

Remarks:

surface hole

Date _____

SEP 8 1948

Scout

Scout **S. J. LEWIS**