


DX 78-1 Rush

**KANSAS**

Section 28 Township 18 Range 16W

Well No. #2 Wilhelm

Company Clark Knight <sup>U</sup> rlg

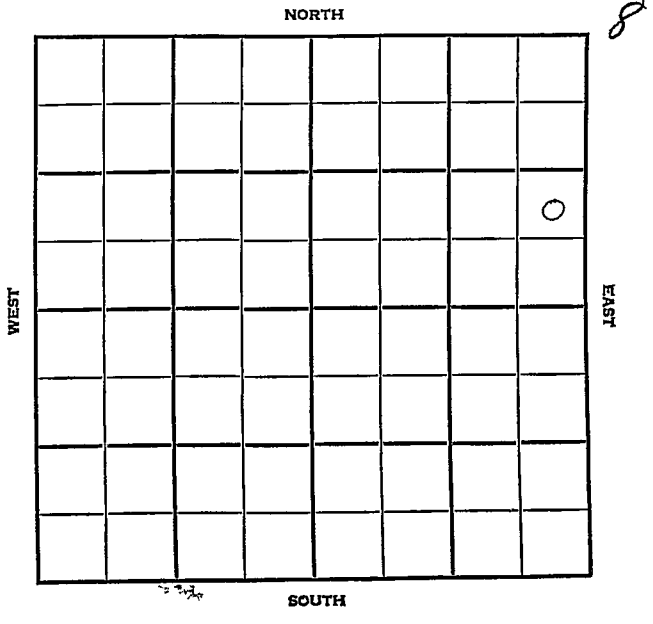

Rush

KANSAS


SEC. 28	TWP. 18	R. 16W
------------	------------	-----------

WELL NO. #2 Wilhelm FARM

COMPANY Clark Knight Drlg.

CONTRACTOR Otis-Albert

\_\_\_\_\_ FT. FROM N. LINE  
 \_\_\_\_\_ FT. FROM S. LINE  
 \_\_\_\_\_ FT. FROM E. LINE  
 \_\_\_\_\_ FT. FROM W. LINE

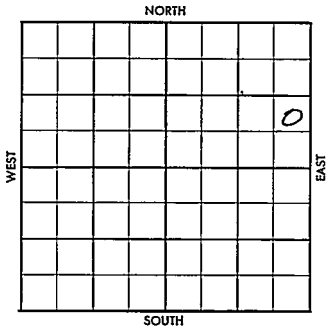

NE SE ~~##~~ NE

1956	ELEVATION 1988'	REPORT
------	--------------------	--------

6-6 Location

7-11 Comm. 6-11-56  
 8 5/8" @ 1045  
 Cored 3597-3639 rec. 35'  
 5 1/2" @ 3638 w/75  
 CO 12/ 3593-96, 17/ 3602-06  
 no ga.  
 P/ 100 BOPD, no wtr.  
 H. 3237'; Tr. 3254'; L. 3298';  
 BKC 3514'; Reag. 3592';  
 TD 3639'

**COMPLETED**



County Hussh Elev. 1983  
 Sec. 28 Twp. 18 Rge. 1/4  
 Company Clerk Knit Int. Inc.  
 Farm Name Wilhelm No. 2

TOPS	DEPTH	LOG	DATUM	Loc. in Sec.
Anh.				17° 57' N
Tr.				
H.	3237			
Tr.	3254			
Dg.				
Bl.				
L.	3298			Geol.
M.C.				Contr.
B.K.C.	3514			
cc. <u>Reag</u>	3592			
C.				
M.				Pool
M.				
K.				
Mz.				Otis-Albert
Mo.				
V.				
S.				
S.				
A.				
R.				
PE.				
G.				
TD.	3639			

JUL 1 1 1956

Date Comm.

Location JUN 1 '56 6-11-56 8 1/4

1045/1 JUN 20 '56 17 3188 JUN 27 '56

crd 3597-3639 rec. 35' 5 1/2

@ 3638 / 75 MICT JUL 3 '56 CO

JUL 11 '56 12/3593-96 17/3602-06

no 90 1/4 Frac T&R POP.

P. 100 Boyd no water