


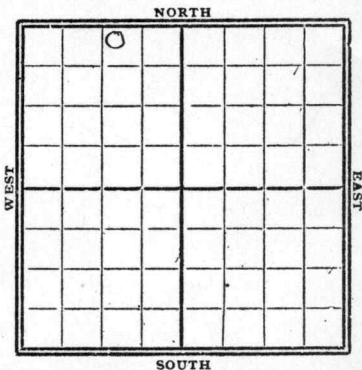

Map No. *ELK* **KANSAS** Sec. *15* Twp. *31* R. *10*  
 Well No. *1-Webb* Farm  
*Croft & Hunt* Company

*100* Ft. from N. Line  
 ..... Ft. from S. Line  
*1220* Ft. from E. Line  
 ..... Ft. from W. Line



*1928*

Date	REPORT
<i>11/7</i>	<i>Rolls</i>
<i>11/14</i>	<i>Timbers</i>
<i>11/21</i>	
<i>11/28</i>	<i>Rig</i>
<i>12/5</i>	<i>Rig in up</i>
<i>12/12</i>	<i>Spud &amp; S.D.</i>
<i>12/19</i>	<i>Spdy 200'</i>
<i>12/26</i>	
<i>1929</i>	
<i>1/2</i>	<i>dry 400'</i>
<i>1/9</i>	<i>" 1125'</i>
<i>1/16</i>	<i>Top sand 1988</i> <i>dry 2002' show oil</i>
<i>1/23</i>	<i>sand 1988-2020 dry</i> <i>T.D. 2020'</i> <i>dry &amp; abandoned</i>

K4 KANSAS MAP NO. \_\_\_\_\_ SEC. 15 TWP. 31 R. 10

WELL No. 1 Wehh  
Croft & Hunt COMPANY

CONTRACTOR

FIRST REPORTS

SECTION PLAT

100 FT. FROM N. LINE  
\_\_\_\_\_ FT. FROM S. LINE  
1220 FT. FROM E. LINE  
\_\_\_\_\_ FT. FROM W. LINE

	0		

LOCATION Pos

RIG UP \_\_\_\_\_

DRILLING AND REMARKS:

RECORD

CASED \_\_\_\_\_ IN., \_\_\_\_\_ FT.  
SAND \_\_\_\_\_  
GAS \_\_\_\_\_  
OIL \_\_\_\_\_  
TOTAL DEPTH \_\_\_\_\_

PRODUCTION

1ST 24 HRS. NAT. \_\_\_\_\_  
1ST 24 HRS. AFTER SHOT \_\_\_\_\_  
GAS \_\_\_\_\_ CU. FT.  
DRY HOLE \_\_\_\_\_  
ABANDONED \_\_\_\_\_

DATE NOV 7 1928

CHAS. L. SHERWOOD

192 \_\_\_\_\_ SCOUT

*Elk*

*K4* **KANSAS** Map No. \_\_\_\_\_ Sec. *15* Twp. *31* R. *10*

Well No. *1 Webb* \_\_\_\_\_

*Croft & Hunt*

Company \_\_\_\_\_

Contractor \_\_\_\_\_

**COMPLETE**

**SECTION PLAT**

*100* Ft. from N. Line

\_\_\_\_\_ Ft. from S. Line

*1770* Ft. from E. Line

\_\_\_\_\_ Ft. from W. Line

	<i>0</i>		

**ABANDONED**

Location \_\_\_\_\_

Rig up \_\_\_\_\_

Drilling and Remarks:

*DDA 2020'*

**RECORD**

Cased \_\_\_\_\_ in. \_\_\_\_\_ ft.

Sand *1988-2020 Dry*

Gas \_\_\_\_\_

Oil \_\_\_\_\_

Total Depth *2020*

**PRODUCTION**

1st 24 hrs. Nat. \_\_\_\_\_

1st 24 hrs. after shot \_\_\_\_\_

Gas \_\_\_\_\_ Cu. Ft.

Dry Hole

Abandoned

Date **JAN 23 1929**

**CHAS. L. SHERWOOD**

192 \_\_\_\_\_

Scout