

Map No. _____ Sec. 27 Twp. 28 R. 5

Well No. 5 Hause Farm
Elwell Company

NORTH

WEST

EAST

SOUTH

Location _____

Drilling Remarks:

Rig Up_____

Drilling Remarks:

RECORD

Cased _____ in. _____ ft.

Sand _____

Gas _____

Oil_____

Total Depth_____

PRODUCTION

1st 24 hrs. Nat._____

1st 24 hrs. after shot_____

Gas_____cu. ft.

Dry Hole _____


Abandoned _____

Map No. _____ Sec. 27 Twp. 28 R. 5Well No. 5 Hause Farm _____
Elwell Company _____200 Ft. from N. Line

_____ Ft. from S. Line

660 Ft. from E. Line

_____ Ft. from W. Line

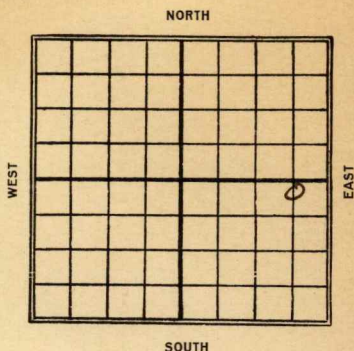

Date

REPORT

1923

1/26 Rig.
3/30 Sand 2751-89 shot 40
ozs. 250 Bbl.

Map No. **KANSAS** Sec. **27** Twp. **28** R. **5**

Well No. **5** *Hanse*
E. Luell Company

Contractor

FIRST REPORT

200 Ft. from N. Line
Ft. from S. Line
660 Ft. from E. Line
Ft. from W. Line

SECTION PLAT

			0

Location

Rig up *✓✓*

Drilling and Remarks:

RECORD

Cased _____ in., _____ ft.
Sand _____
Gas _____
Oil _____
Total Depth _____

PRODUCTION

1st 24 hrs. Nat. _____
1st 24 hrs. after shot _____
Gas _____ Cu. Ft.
Dry Hole _____
Abandoned _____

Date **JAN 26 1923**

191 **M. A. BENEAR** Scout

Map No. **KANSAS** 11 Sec. 27 Twp. 28 R. 5Well No. 5 HarpeC. Swell Company

Contractor

COMPLETED SECTION PLAT200 Ft. from N. Line

Ft. from S. Line

660 Ft. from E. Line

Ft. from W. Line

			o

Location

Rig up

Drilling and Remarks:

2 and { 2751
2789shot 40/250**RECORD**

Cased _____ in., _____ ft.

Sand _____

Gas _____

Oil _____

Total Depth _____

PRODUCTION

1st 24 hrs. Nat. _____

1st 24 hrs. after shot _____

Gas _____ Cu. Ft.

Dry Hole _____

Abandoned _____

Date

MAR 30 1923

M. A. BENEAR

_____ 191 _____ Scout