

Map No. _____ Sec. 27 Twp. 28 R. 5
Well No. 8 House _____ Farm
Elwell & Co _____ Company

NORTH

WEST

EAST

SOUTH

Location _____

Drilling Remarks:

Rig up _____

Drilling Remarks:

RECORD

Cased _____ in. _____ ft.

Sand _____

Gas _____

Oil _____

Total Depth_____

PRODUCTION

1st 24 hrs Nat. _____

1st 24 hrs. after shot_____

Gas _____ cu. ft.

Dry Hole_____

Abandoned _____

Map No. _____ Sec. 27 Twp. 28 R. 5


Well No. 8 House Farm
Elwell Elal Company

1120 Ft. from N. Line

_____ Ft. from S. Line

_____ Ft. from E. Line

200 Ft. from W. Line

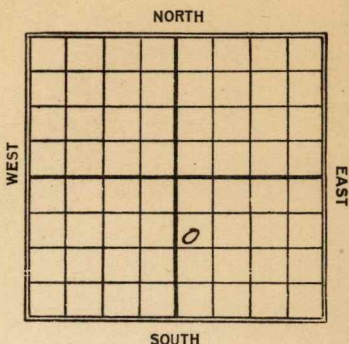

Date _____

REPORT

1923

6/10

Ring

8/9

2. '79. 2820'

Map No. **KANSAS** 11 27 Sec. 28 Twp. 5 R. 5

Well No. 8 House

E. L. Well et al Company

Contractor

FIRST REPORT

SECTION PLAT

1120 Ft. from N. Line

Ft. from S. Line

Ft. from E. Line

200 Ft. from W. Line

		0	

Location

Rig up ✓ ✓

Drilling and Remarks:

RECORD

Cased _____ in., _____ ft.

Sand _____

Gas _____

Oil _____

Total Depth _____

PRODUCTION

1st 24 hrs. Nat. _____

1st 24 hrs. after shot _____

Gas _____ Cu. Ft.

Dry Hole _____

Abandoned _____

Date

JUN 10 1923

E. A. BENLAR

192

Scout

Map No. 11 **KANSAS** Sec. 27 Twp. 28 R. 5

Well No. 8 Norse

E. Swell et al Company

Contractor

ABANDONED SECTION PLAT

1120 Ft. from N. Line

_____ Ft. from S. Line

_____ Ft. from E. Line

200 Ft. from W. Line

		0	

Location _____

Rig up _____

Drilling and Remarks:

20 x 1
2820'

RECORD

Cased _____ in., _____ ft.

Sand _____

Gas _____

Oil _____

Total Depth _____

PRODUCTION

1st 24 hrs. Nat. _____

1st 24 hrs. after shot _____

Gas _____ Cu. Ft.

Dry Hole _____

Abandoned _____

Date

AUG 4 1923
192

M. A. BENEAR

Scout