

Section 29 Township 18 Range 16 W
Well No. # 1 Luft
Company Overland Drlg.

NORTH

/

							0

SOUTH

WEST

EAST

Sec. 29 Twp. 18 R. 16 W

Well No. # 1 Luft Farm

Overland Drlg. Company

Overland Drlg. Contractor

Wildcat


330 Ft. from N. Line

Ft. from S. Line

330 Ft. from E. Line

Ft. from W. Line

NE NE NE
MCPC has $\frac{1}{4}$ min. int.
in NW/4 of 28

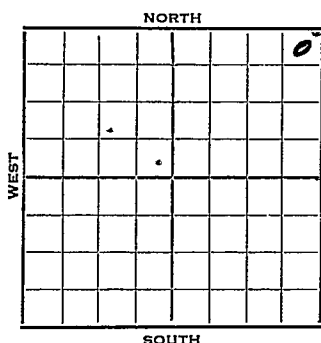

1953 Elev. 2022: REPORT

7/1	Spud 6-30-53
7/9	Anhy 1068' 8" @ 1080' Drlg. 3067' (Ltr-McGehee)
7/16	Heeb 3268' KC 3338' DST 3359-3427, 40 mins, good blow, 960' SW. 1245# Regan sd 3616-34' RTD 5" @ 3624 WOCT (Ltr-McGehee)
7/23	CO to 3634' SSO DD 3640' FU 800' oil in 1 hr. S/1 $\frac{1}{2}$ BOPH 8 hr. Gr est 37. Hydro. (Ltr-McGehee)
7/30	After hydrofrac filled up 2300' oil. S/15 BOPH 1500' off bottom. POP. (Ltr-McGehee)
8/5	No report
8/12	"
8/20	P/1 BO 4 BW To PB " "
8/26	PB 3636'
9/2	sd-o-frac P/ 40 bopd / 50% wtr.
9/9	N.R.
9/16	"
9/23	"
9/30	"
10/7	"

OVER

County Rush State KansasSec. 29 (Blk. Twp.) 18 (Sur. Rgs.) 16W Map No.Operator Overland Drilg.Well No. 1 Farm LuftElev. Location NE NE NE

						0

FIRST REPORT

330 Ft. From N Line NE330 Ft. From E Line Quarter1st. Report JUL 1 1953

Completion

Remarks MCPC has $\frac{1}{4}$ min. int.
in NW/4 of 28Spudding Date 6-30-53Drilg. Data Wildcat

1953
10/14

Spud 6-30-53 Oil well TD 3640
Anhy 1068 8" @ 1080 Heeb 3268
KC 3338

DST 3359-3427 open 40 min rec 960' SW
1245# Regan sd 3616' -1594

TD 3634 5" @ 3624 CO to 3634

DD 3640 FU 800' oil 1 hr.

S/1 $\frac{1}{2}$ BOPH 8 hr. Hydro. FU 2300'

oil S/15 BOPH P/1 BO 4 BW

PB 3636 sd-621-frac P/40 BOPD

50% wtr. 1500 BO total oil in 6 wks.
Comp.

COMPLETED