


Rush

KANSAS

SECTION 29 TOWNSHIP 18 RANGE 16W

WELL NO. ~~2~~<sup>3</sup> Luft

COMPANY Luft & Weber

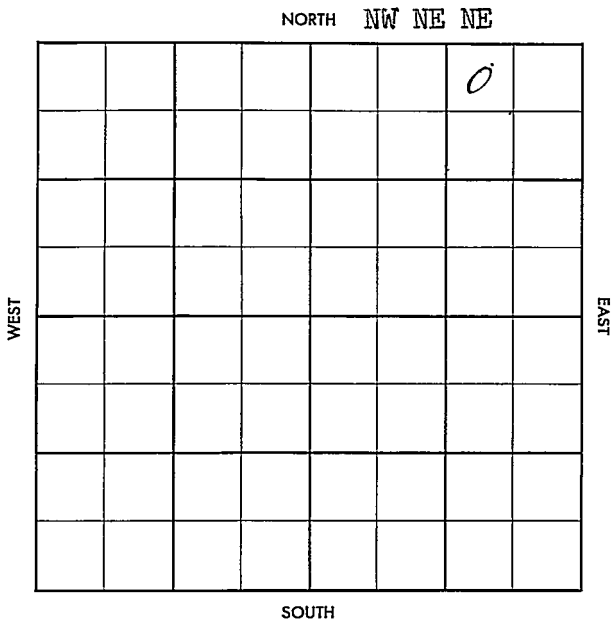

County Hush Elev. \_\_\_\_\_  
 Sec. 29 Twp. 18 Rge. 16W  
 Company Luft & Weber  
 Farm Name Luft No. 2

TOPS	DEPTH	LOG	DATUM
Anh.			
Ep.			
H.			
Tr.			
Dg.			
Bl.			
L.			
K.C.			
B.K.C.			
Ce.			
C.			
M.			
M.			
K.			
Mz.			
Ma.			
V.			
S.			
S.			
A.			
R.			
Pe.			
G.			
T.D.			

Loc. in Sec. NW NE NE  
 Geol. \_\_\_\_\_  
 Contr. Fenton Drlg.  
 Pool Otis-Albert

			10
FIRST RECORD			
FEB 13 57			

Date Comm. 2-10-57

Drlg 600' on surface hole

14

Co.  
 Use.  
 No.  
 Sec.  
 T.  
 R.

# CORRECTION

FORM 513 SUNRAE

County Rush Elev. 2046  
 Sec. 29 Twp. 18 Rge. 16W  
 Company Luft & Weber  
 Farm Name Luft No. 33

TOPS	DEPTH	LOG	DATUM	Loc. in Sec.
Anh.	1090			NW NE NE
Tr.				
H.	3302			
Tr.				
Dg.				
Bl.				
L.	3361			Geol. _____
K.C.				Contr. _____
B.K.C.				
Ce.				
C.				Fenton Drl
M.				Pool
M.				Otis-Albert
K.				
Mz.				
Ma.				
V.				
S.				
S.				
A.				
R. <u>sd</u>	3654			
PE.				
G.				
T.D.	3698			

10  
 MAR 27 '57  
**ABANDONED**

Date Comm. 2-10-57

Drlg 600' on surface hole 4.2.1.57 8 5/8  
1100/500 # 3377  
ord 3656-98 rec 42' 5 1/2 3698  
175 MICT MAR 5 '57 MAR 7 '57 MAR 20 '57 ✓  
MAR 27 '57 co 3680 8/3657-59 not st  
1/2 frac @ 95% wtu

DEA ~~test~~