


Map No. **KANSAS** Sec. **16** Twp. **31** R. **10**

Well No. **1 - Meyers** Farm
Davis-Hazlett Company

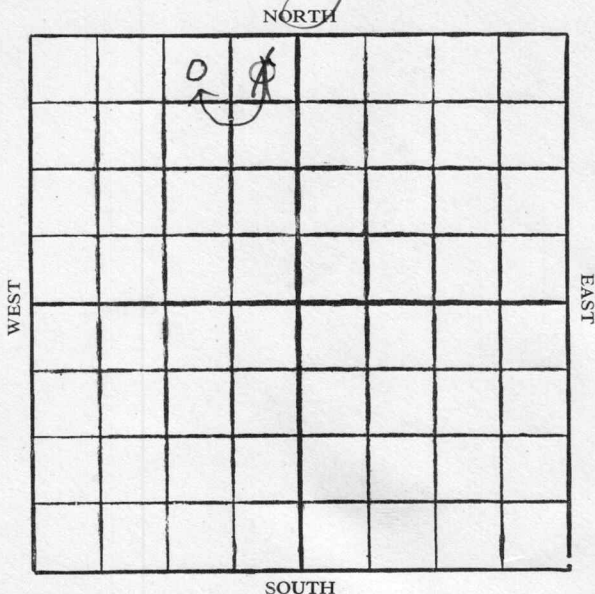

Location

Drilling Remarks

Rig Up

Drilling Remarks

RECORD

Cased in. ft.

Sand

Gas

Oil

Total Depth

PRODUCTION

1st 24 hrs. Nat.

1st 24 hrs. after shot

Gas cu. ft.

Dry Hole

Abandoned

Els

MAP NO. 4 KANSAS SEC. 16 TWP. 31 R. 10^E

WELL No. 1 Meyers
Davis - Hazlett et al COMPANY

CONTRACTOR

FIRST REPORTS

SECTION PLAT

330 FT. FROM N. LINE
____ FT. FROM S. LINE
330 FT. FROM E. LINE
____ FT. FROM W. LINE

	o		

LOCATION _____

RIG UP _____

DRILLING AND REMARKS:

Spdy

RECORD

CASED _____ IN. _____ FT.

SAND _____

GAS _____

OIL ARM HAMC oil

TOTAL DEPTH _____

PRODUCTION

1ST 24 HRS. NAT. _____

1ST 24 HRS. AFTER SHOT _____

GAS _____ CU. FT.

DRY HOLE _____

ABANDONED _____

DATE
MAY 10 1928

CHAS. L. SHERWOOD

Tulsa

4 KANSAS
Map No. _____ Sec. *16* Twp. *31* R. *10*

Well No. *1* _____

Davis - Hazlett et al Company

_____ Contractor

330 CORRECTION
_____ Ft. from N. Line

_____ Ft. from S. Line

990 _____ Ft. from E. Line

_____ Ft. from W. Line

SECTION PLAT

	<i>98</i>		

Location _____

Rig up *Spdy* _____

Drilling and Remarks:

By location

RECORD

Cased _____ in., _____ ft.

Sand _____

Gas _____

Oil _____

Total Depth _____

PRODUCTION

1st 24 hrs. Nat. _____

1st 24 hrs. after shot _____

Gas _____ Cu. Ft.

Dry Hole _____

Abandoned _____

Date

MAY 17 1928

CHAS. L. SHERWOOD

192

Scout

K4 KANSAS Map No. _____ Sec. *16* Twp. *31* R. *10*

Well No. *1* _____

Jervis O. Hazlett Company

Contractor _____

COMPLETED

SECTION PLAT

320 Ft. from N. Line

_____ Ft. from S. Line

990 Ft. from E. Line

_____ Ft. from W. Line

	<i>0</i>		

ABANDONED

Location _____

Rig up _____

Drilling and Remarks:

TL 2015

Day 2360

RECORD

Cased _____ in., _____ ft.

Sand _____

Gas _____

Oil _____

Total Depth *2360*

PRODUCTION

1st 24 hrs. Nat. _____

1st 24 hrs. after shot _____

Gas _____ Cu. Ft.

Dry Hole

Abandoned

Date

JUN 23 1928

CHAS. L. SHERWOOD
Scout