

Map No. _____ Sec. 27 Twp. 28 R. 2

Well No. 7 McLaughlin Farm

Reese & Arkison Company

NORTH

WEST

EAST

SOUTH

Location _____

Drilling Remarks:

Rig Up_____

Drilling Remarks:

RECORD

Cased _____ in. _____ ft.

Sand _____

Gas _____

Oil_____

Total Depth_____

PRODUCTION

1st 24 hrs. Nat._____

1st 24 hrs. after shot_____

Gas _____ cu. ft.

Dry Hole _____

Abandoned _____

Map No. _____ Sec. 27 Twp. 28 R. 5Well No. 7 McLaughlin Farm
Reese & Aikmon Company

NORTH


_____ Ft. from N. Line

200 Ft. from S. Line

WEST

1120 Ft. from E. Line

_____ Ft. from W. Line

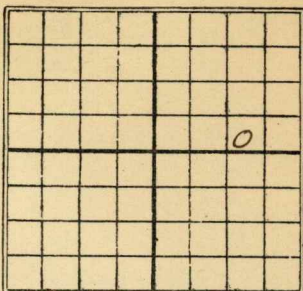

EAST

SOUTH

Date

REPORT

19232/63/30

Rig:
Sand 2771-2800 - Shot
30 gts. 100 Bbls.

Map No. KANSAS Sec. 27 Twp. 27 R. 5Well No. 7 M^o LangblinReese & Ribmon Company

Contractor

FIRST REPORT

Ft. from N. Line

200' Ft. from S. Line1120' Ft. from E. Line

Ft. from W. Line

SECTION PLAT

Location

Rig up RV

Drilling and Remarks:

RECORD

Cased _____ in., _____ ft.

Sand _____

Gas _____

Oil _____

Total Depth _____

PRODUCTION

1st 24 hrs. Nat. _____

1st 24 hrs. after shot _____

Gas _____ Cu. Ft.

Dry Hole _____

Abandoned _____

Date

FEB 6 1923

M. A. BENEAR

191

Scout

Map No. **KANSAS** Sec. **27** Twp. **28** R. **5**Well No. **7 McLaughlin****Reese & Piekman** Company

Contractor

COMPLETED SECTION PLAT

Ft. from N. Line

200

Ft. from S. Line

1120

Ft. from E. Line

Ft. from W. Line

			0

Location

Rig up

Drilling and Remarks:

**sand { 2771
2800****shot 30/100****RECORD**

Cased _____ in., _____ ft.

Sand _____

Gas _____

Oil _____

Total Depth _____

PRODUCTION

1st 24 hrs. Nat. _____

1st 24 hrs. after shot _____

Gas _____ Cu. Ft.

Dry Hole _____

Abandoned _____

Date

MAR 30 1923**M. A. BENEAR**

_____ 191 _____

Scout