


Map No. 71 Sec. 27 Twp. 28 R. 5
 Well No. 1 Meyers Farm
Hannay Etal Company
 NORTH

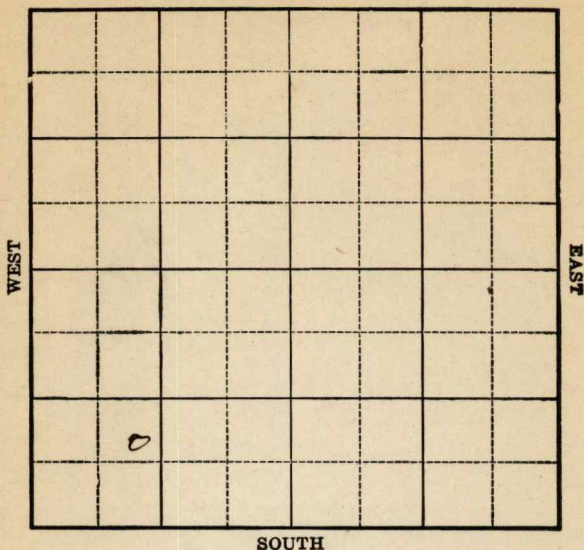

Location _____

Drilling Remarks:

RECORD

Cased _____ in. _____ ft.
 Sand _____
 Gas _____
 Oil _____
 Total Depth _____

Rig Up _____

Drilling Remarks:

PRODUCTION

1st 24 hrs. Nat. _____
 1st 24 hrs. after shot _____
 Gas _____ cu. ft.
 Dry Hole _____
 Abandoned _____

Map No. 7 Sec. 27 Twp. 28 R. 5

Well No. 2 Farm 1


No. 7 Farm
Ramsay & Co. Company

Ft. from N. Line

760 Ft. from S. Line

Ft. from E. Line

1120 Ft. from W. Line

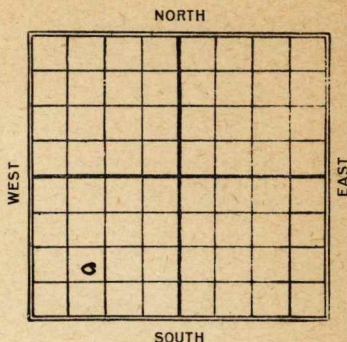

Date 19 Feb

REPORT

9/9	Sand		
11/19	Sand 2761-87	80 gts	
	40 Bbls		

11
 Map No. **KANSAS** Sec. 27 Twp. 28 R. 5
Well No. 1Ramsay et al Company

Contractor

FIRST REPORT

_____ Ft. from N. Line

760 Ft. from S. Line

_____ Ft. from E. Line

1120 Ft. from W. Line

SECTION PLAT

Location _____

Rig up _____

Drilling and Remarks:

spud

RECORD

Cased _____ in., _____ ft.

Sand _____

Gas _____

Oil _____

Total Depth _____

PRODUCTION

1st 24 hrs. Nat. _____

1st 24 hrs. after shot _____

Gas _____ Cu. Ft.

Dry Hole _____

Abandoned _____

Date

SEP

9 1924
192

M. A. BENEAR

Scout

11
 Map No. **KANSAS** Sec. *27* Twp. *28* R. *5*
Well No. *1 Meyers**Ramsay et al* Company

Contractor

COMPLETED**SECTION PLAT**

-----Ft. from N. Line

760 -----Ft. from S. Line

-----Ft. from E. Line

1120 -----Ft. from W. Line

<i>0</i>			

Location -----

Rig up -----

Drilling and Remarks:

*Sand 2761-87**80/40***RECORD**

Cased ----- in., ----- ft.

Sand -----

Gas -----

Oil -----

Total Depth -----

PRODUCTION

1st 24 hrs. Nat. -----

1st 24 hrs. after shot -----

Gas ----- Cu. Ft.

Dry Hole -----

Abandoned -----

Date

NOV 19 1924

192

M. A. BENEAR

Scout