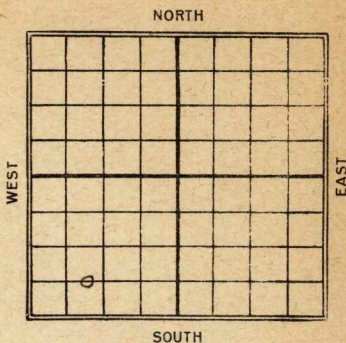


Map No. K Sec. 27 Twp. 28 R. 5Well No. #2 Myers Farm
Ramsay et al Company

Ft. from N. Line

470 Ft. from S. Line

Ft. from E. Line

1090 Ft. from W. Line

Date

REPORT

192411/19Rig up12/17Log 1615'19251/21Sand 2755-88 15 Bbls
120 gts

11
 Map No. **KANSAS** Sec. 27 Twp. 28 R. 5
Well No. 2 MeyersRamsay et al Company

Contractor

FIRST REPORT

Ft. from N. Line

470 Ft. from S. Line

Ft. from E. Line

1090 Ft. from W. Line

SECTION PLAT

Location

Rig up ✓✓

Drilling and Remarks:

RECORD

Cased _____ in., _____ ft.

Sand _____

Gas _____

Oil _____

Total Depth _____

PRODUCTION

1st 24 hrs. Nat. _____

1st 24 hrs. after shot _____

Gas _____ Cu. Ft.

Dry Hole _____

Abandoned _____

Date

NOV 19 1924

M. A. BENEAR

192

Scout

11 **KANSAS**
 Map No. _____ Sec. 27 Twp. 28 R. 5

Well No. 2 Myers

Ramsey et al Company

Contractor

COMPLETED SECTION PLAT

_____ Ft. from N. Line

470 _____ Ft. from S. Line

_____ Ft. from E. Line

1090 _____ Ft. from W. Line

Location _____

Rig up _____

Drilling and Remarks:

sand 2755-88

120/15

RECORD

Cased _____ in., _____ ft.

Sand _____

Gas _____

Oil _____

Total Depth _____

PRODUCTION

1st 24 hrs. Nat. _____

1st 24 hrs. after shot _____

Gas _____ Cu. Ft.

Dry Hole _____

Abandoned _____

Date

1/21 1925

M. A. BENEAR

Scout