

Map No. _____ Sec. 27 Twp. 28 R. 5
Well No. 3 Meyers Farm _____
A. A. Company _____

NORTH

WEST

EAST

SOUTH

Location _____

Drilling Remarks:

Rig up _____

Drilling Remarks:

RECORD

Cased _____ in. _____ ft.

Sand _____

Gas _____

Oil _____

Total Depth_____

PRODUCTION

1st 24 hrs Nat. _____

1st 24 hrs. after shot

Gas_____cu. ft.

Dry Hole_____


Abandoned _____

Map No. _____ Sec. 27 Twp. 28 R. 5Well No. 3 Meyers Farm _____S. & S. Company _____1120 Ft. from N. Line

_____ Ft. from S. Line

200 Ft. from E. Line

_____ Ft. from W. Line

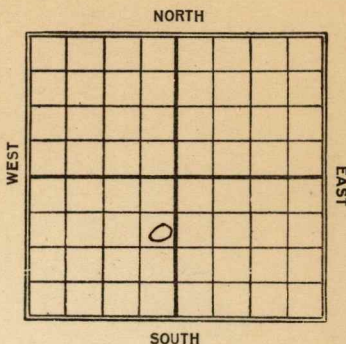

Date	REPORT
1923	
3/22	Reg.
6/23	Sand 2758-85-Shot 10 yds. 250 Bbs.

Map No. **KANSAS** Sec. **27** Twp. **28** R. **5**
 Well No. **3-Meyers**
S + S. Company

Contractor

FIRST REPORT

1120 Ft. from N. Line

_____ Ft. from S. Line

200 Ft. from E. Line

_____ Ft. from W. Line

SECTION PLAT

Location _____

Rig up **✓✓**

Drilling and Remarks:

RECORD

Cased _____ in., _____ ft.

Sand _____

Gas _____

Oil _____

Total Depth _____

PRODUCTION

1st 24 hrs. Nat. _____

1st 24 hrs. after shot _____

Gas _____ Cu. Ft.

Dry Hole _____

Abandoned _____

Date

MAR 22 1923

192

M. A. BENEAR

Scout

Map No. **KANSAS** 11 Sec. **27** Twp. **28** R. **3**Well No. **3 Myers**

Company

Contractor

COMPLETED SECTION PLAT**1120** Ft. from N. Line

Ft. from S. Line

200 Ft. from E. Line

Ft. from W. Line

Location

Rig up

Drilling and Remarks:

RECORD
Cased _____ in., _____ ft.

Sand _____

Gas _____

Oil _____

Total Depth _____

PRODUCTION

1st 24 hrs. Nat. _____

1st 24 hrs. after shot _____

Gas _____ Cu. Ft.

Dry Hole _____

Abandoned _____

Date

JUN 23 1923**M. A. BENEAR**

192

Scout