


Section 18 Township 31 Range 10-E

Well No. 1 Pfrehm

Company Imo Oil

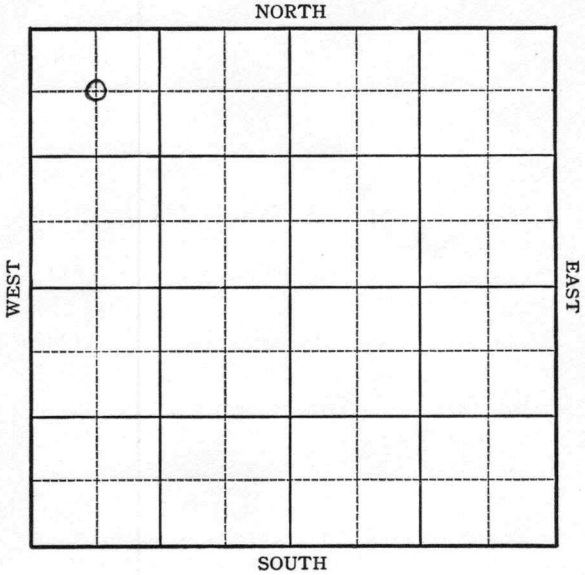

Sec. 18 Twp. 31 R. 10-E


Well No. #1 Pfrehn Farm _____
Imo Oil Company _____

660 Ft. from N. Line

_____ Ft. from S. Line

_____ Ft. from E. Line

660 Ft. from W. Line

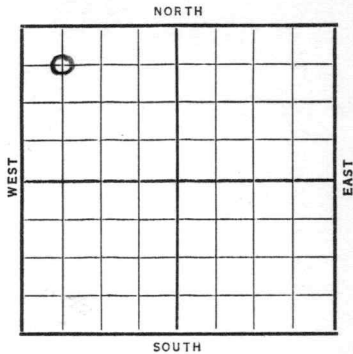

Date	REPORT
1937	
10/13	Mach.
10/22	T.D. 150' SD.
10/29	12" @ 589'. Drlg. 600'.
11/5	" " " "
11/12	Drlg. 1560'.
11/19	" "
11/26	" "
12/3	10" @ 776'. 8" @ 1484'.
	Miss. 2229'. 6" @ 2232'.
	T.D. 2245'. 150' oil 5 hrs.
	1000 acid.
12/10	" "
12/17	" "
12/22	6" @ 2232'.
	Miss. 2229'.
	T.D. 2245'.
	1000 acid.
	Went to water.
	ABANDONED

ELK

Map No. 4 Sec. 18 Twp. 31 R. 10E

Well No. 1 Pfrehn

Imo Oil Company

Contractor

FIRST REPORT

C NW NW

SECTION PLAT

660 Ft. from N. Line

0			

_____ Ft. from S. Line

_____ Ft. from E. Line

660 Ft. from W. Line

Location _____

RECORD

Rig up _____

Cased _____ in., _____ ft.

Drilling and Remarks:

Sand _____

Mach

Gas _____

Oil _____

Total Depth _____

PRODUCTION

1st 24 hrs. Nat. _____

1st 24 hrs. after shot _____

Gas _____ Cu. Ft.

Dry Hole _____

Abandoned _____

Date

OCT 13 1937 19

H. D. Hatfield Scout

Elk

KANSAS

Map No. 4 Sec. 18 Twp. 31 R. 10E

Well No. 1 Pfrehn

Imo Oil Company

Contractor

ABANDONED

SECTION PLAT

C NW NW

660 Ft. from N. Line

_____ Ft. from S. Line

_____ Ft. from E. Line

660 Ft. from W. Line

0			

Location _____

Rig up _____

Drilling and Remarks:

*1000 acid
went to water*

DVA

RECORD

Cased 6 in., 2232 ft.

Sand MISS 2229

Gas _____

Oil _____

Total Depth 2245

PRODUCTION

1st 24 hrs. Nat. _____

1st 24 hrs. after shot _____

Gas _____ Cu. Ft.

Dry Hole _____

Abandoned _____

Date

DEC 22 1937

19

H. D. Hatfield

Scout