

ELK

Map No. Kansas Sec. 21 Twp. 31 R. 10

Well No. 1 Farm


Waldron Oil Company

_____ Ft. from N. Line

200 Ft. from S. Line

200 Ft. from E. Line

_____ Ft. from W. Line

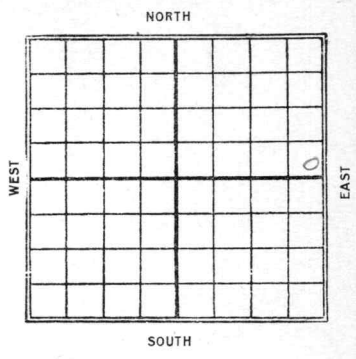

Date
1927
1/8

REPORT

Abandoned 2380

Map No. **4** KANSAS Sec. **21** Twp. **31** R. **10**

Well No. **1**
Waldron Oil Co Company

Contractor

FIRST REPORTS

SECTION PLAT

----- Ft. from N. Line

200

----- Ft. from S. Line

200

----- Ft. from E. Line

----- Ft. from W. Line

COMPLETED

			0
ABANDONED			

Location -----

Rig up -----

Drilling and Remarks:

RECORD

Cased ----- in., ----- ft.

Sand -----

Gas -----

Oil -----

Total Depth **2380**

PRODUCTION

1st 24 hrs. Nat. -----

1st 24 hrs. after shot -----

Gas ----- Cu. Ft.

Dry Hole

Abandoned

Date

JAN 8 1927

CHAS. L. SHERWOOD

192

Scout