


ELK

Map No. Kansas Sec. 20 Twp. 31 R. 10E

Well No. 1 Baker Farm
Neely O. & G. Company

..... Ft. from N. Line
250 Ft. from S. Line
250 Ft. from E. Line
..... Ft. from W. Line

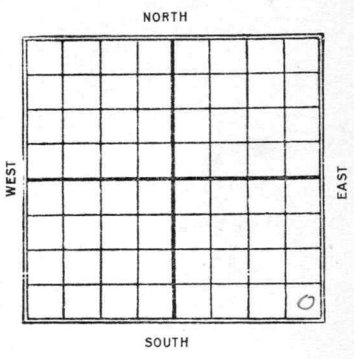

Date
1927

REPORT

1/8 Sand 1542-1555
40 gts 30 bbls

4 KANSAS
 Map No. _____ Sec. 20 Twp. 31 R. 10 E
 Well No. 1
 Neely Oil & Co Company
 Contractor

FIRST REPORTS

_____ Ft. from N. Line
 250 Ft. from S. Line
 250 Ft. from E. Line
 _____ Ft. from W. Line
 COMPLETED

SECTION PLAT

			0

Location _____
 Rig up _____
 Drilling and Remarks:

40/30 lbs.

RECORD

Cased _____ in., _____ ft.
 Sand 1542-1555
 Gas _____
 Oil _____
 Total Depth 1555

PRODUCTION

1st 24 hrs. Nat. _____
 1st 24 hrs. after shot _____
 Gas _____ Cu. Ft.
 Dry Hole _____
 Abandoned _____

Date
 JAN 8 1907

192 CHAS. L. SHERWOOD Scout