



ELK

Map No. Kansas Sec. 22 Twp. 31 R. 10<sup>E</sup>

Well No. 1- Rorick Farm


R. G. GILLESPIE Company

..... Ft. from N. Line

330 Ft. from S. Line

330 Ft. from E. Line

..... Ft. from W. Line

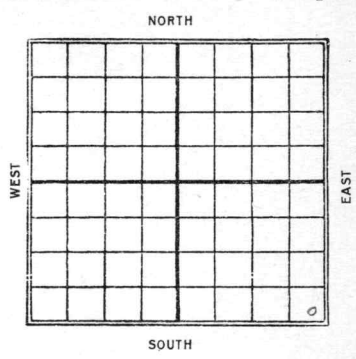

Date  
1927

REPORT

1/8 Sand 1613-1626  
Top Line 1608 180 bbls  
1325-45 45 bbls  
shot 40 gts

6215

4 KANSAS

Map No. ----- Sec. 22 Twp. 31 R. 10 <sup>W</sup>

Well No. 1 <sup>Bohicks</sup> -----

H. S. Gillespie

Company

Contractor

### FIRST REPORTS

### SECTION PLAT

----- Ft. from N. Line

330 Ft. from S. Line

330 Ft. from E. Line

----- Ft. from W. Line

COMPLETED

			o

Location -----

Rig up -----

Drilling and Remarks:

top line 1608  
180 ft

### RECORD

Cased \_\_\_\_\_ in., \_\_\_\_\_ ft.

Sand 1613-1626

Gas -----

Oil -----

Total Depth 1626

### PRODUCTION

1st 24 hrs. Nat. -----

1st 24 hrs. after shot -----

Gas ----- Cu. Ft.

Dry Hole -----

Abandoned -----

had 45 ft well  
from 1325-45  
was shot 40'

Date

JAN 8 1927

CHAS. L. SHERWOOD

192

Scout