


Map No. 15 Sec. 22 Twp. 31 R. 10
 Well No. 3 - Porick Farm
R. S. Gillispie Company

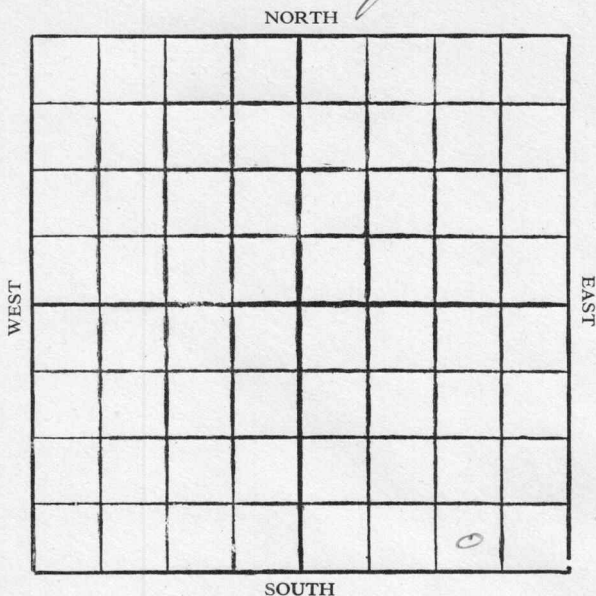

Location

Drilling Remarks

Rig Up

Drilling Remarks

RECORD

Cased in. ft.

Sand

Gas

Oil

Total Depth

PRODUCTION

1st 24 hrs. Nat.

1st 24 hrs. after shot

Gas cu. ft.

Dry Hole


Abandoned

Map No. KAN 579 Sec. 22 Twp. 31 R. 10^EWell No. 3 Rorick FarmR. G. GILLESPIE Company

_____ Ft. from N. Line

330 Ft. from S. Line990 Ft. from E. Line

_____ Ft. from W. Line

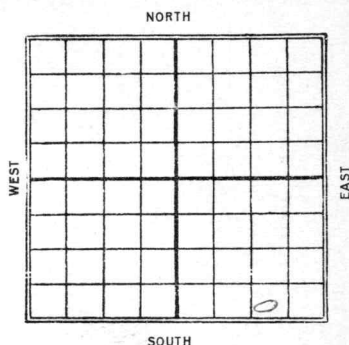

Date

REPORT

1927

1/8 Sand 1628-1630 25 bbls

Sand 1332-1342 15 bbls

60 gts

Elk
4 KANSAS *22* *31* *10* ✓
Map No. Sec. Twp. R.
Well No. *3* *KORACK*
H. S. Sillescu Company

FIRST REPORTS

SECTION PLAT

_____ Ft. from N. Line
330 _____ Ft. from S. Line
990 _____ Ft. from E. Line
_____ Ft. from W. Line
COMPLETED

			0

Location _____
Rig up _____
Drilling and Remarks:
25 lbs
had 15 lb weed
from 1332-1342
was shot by

RECORD

Cased *1628-1630* in., *1630* ft.
Sand _____
Gas _____
Oil _____
Total Depth *1630*

PRODUCTION

1st 24 hrs. Nat. _____
1st 24 hrs. after shot _____
Gas _____ Cu. Ft.
Dry Hole _____
Abandoned _____

Date

JAN 8 1927

CHAS. L. SHERWOOD

192

Scout