

Sec. 30 Twp. 28 R. 5 E

Well No. # 1 Hughes Farm

E. F. Wakefield Company

Semi-Wildcat Contractor


_____ Ft. from N. Line

330 Ft. from S. Line

_____ Ft. from E. Line

990 Ft. from W. Line

SE SW SE

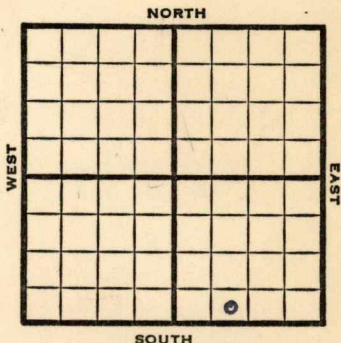

1952

Elev. -

REPORT

8/6

Spud 7-29-52

8" @ 93' Bart zone 2761'

Miss 2799-2833' TD 2833'

D & A

FIRST REPORT

ABANDONED

