


Section 31 Township 28 Range 5 E

Well No. # 1 Bare

Company White & Ellis

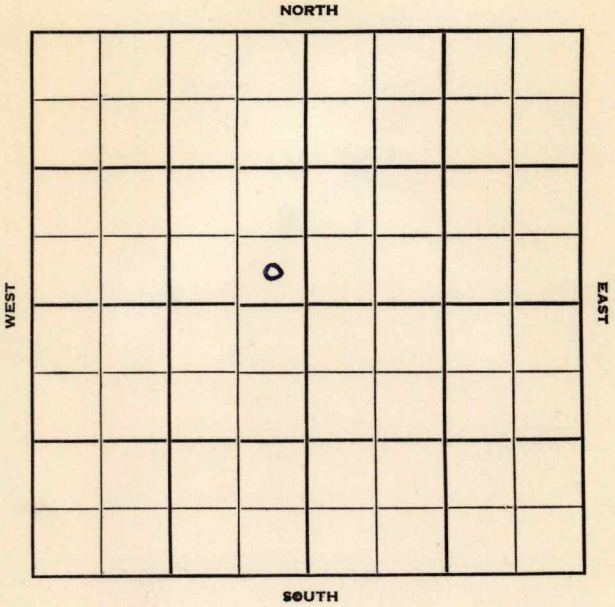

Sec. 31 Twp. 28 R. 5E

Well No. #1 Bare Farm

White & Ellis Company


White & Ellis Contractor

Wildcat

Ft. from N. Line

NORTH

330 Ft. from S. Line

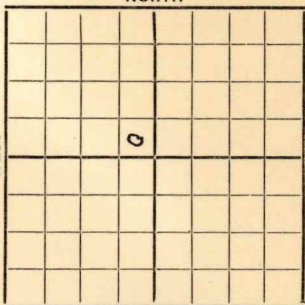

330 Ft. from E. Line

Ft. from W. Line

SE SE NW

SOUTH

1952 Elev. 1287 REPORT

5/28 Spud 5-26-52  
8" @ 23'  
Drlg. 250'

7/16 Spud 5-26-52  
Oil Well TD 2814  
8" @ 23 Lans. 1873 KC 2245  
Bart 2775-93 TD 2814 5" @ 2787  
CO to 2814 PB 2795 FU 14 go 10 gw  
8hr. PB 2792  
35/2778-84 2788-89 Hydro  
S/load S/5 boph FU 600' oil  
FU 1200' oil 12 hr. Comp. 11 bopd 3 bw

COMPLETED



County **Butler** State **Kansas**

Sec. **31** (Blk. Twp.) **28** (Sur. Rge.) **5E** Map No.

Operator **White & Ellis**

Well No. **1** Farm **Bare**

Elev. Location **SE SE NW**


**FIRST REPORT**

**330** Ft. From **S** Line **NW**

**330** Ft. From **E** Line Quarter

1st. Report **MAY 28 1952**

Completion

Remarks

**White & Ellis - Contr.**

Spudding Date **5-26-52**

Drlg. Data **Wildcat**

**8" @ 23 Drlg. 250**

**J. G. MCGEHEE**